


Section 26 Township 11 Range 17-W

Well No. #15 McCord

Company Cities Service

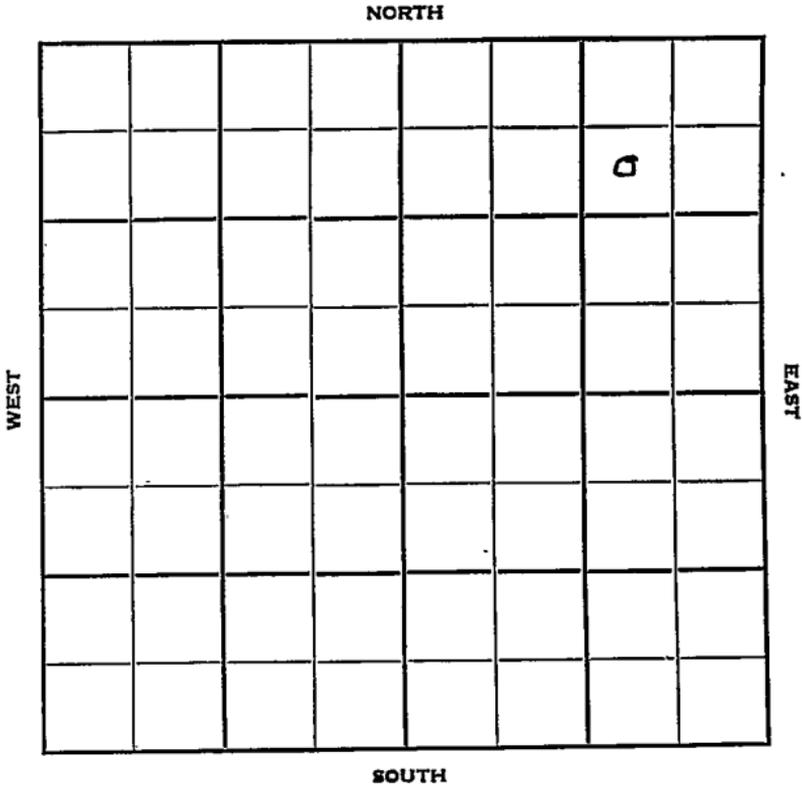

Sec. 26 Twp. II R. 17-W ✓

Well No. #15 McCord Farm

Cities Service Company

\* Contractor

Bemis


915 Ft. from N. Line

\_\_\_\_\_ Ft. from S. Line

990 Ft. from E. Line

\_\_\_\_\_ Ft. from W. Line

SW NE NE

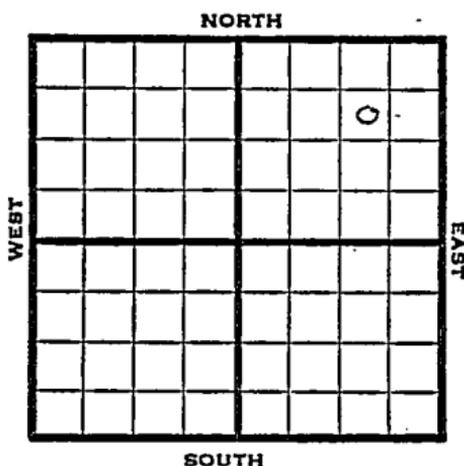

1950

Elev. 2087

REPORT

~~11/8~~  
1/31

Cellar & Pits  
 Oil well TD 3650  
 8" @216  
 ReArb. 3557 Arb. 3560  
 5" @3650 TD 3650  
 22/3613-19 250 A  
 P/ 84 bo 106 bwpd  
 Comp. 44 bopd 74% water

COMPLETED



