


Section 26 Township 11 Range 17-W

Well No. #14 McGord

Company Cities Service

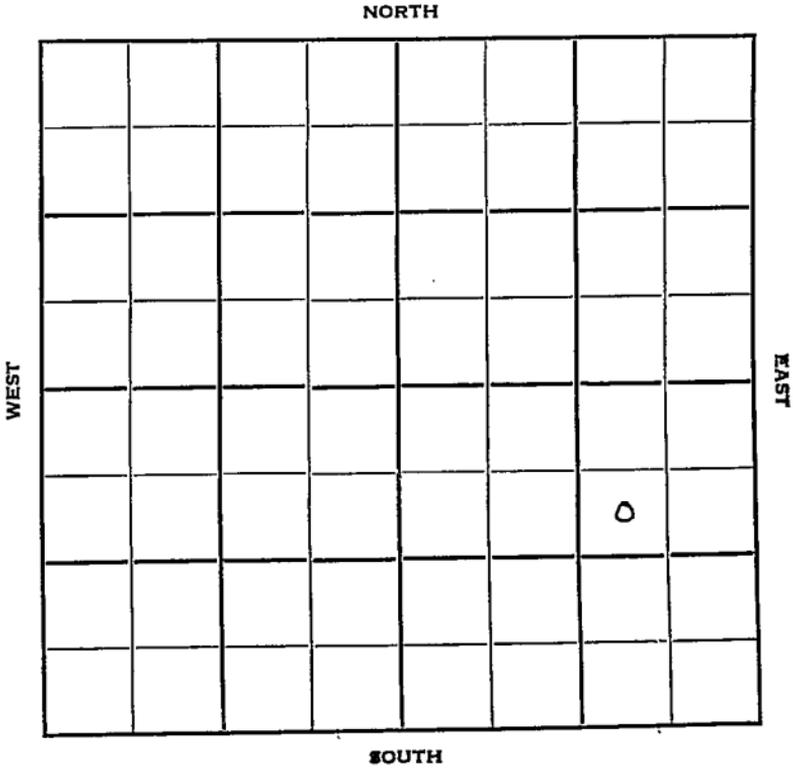

Sec. 26 Twp. 11 R. 17-W

Well No. #14 McCord Farm _____

Cities Service Company _____

Contractor _____


Bemis
990 Ft. from N. Line

_____ Ft. from S. Line

990 Ft. from E. Line

_____ Ft. from W. Line

SW NE SE

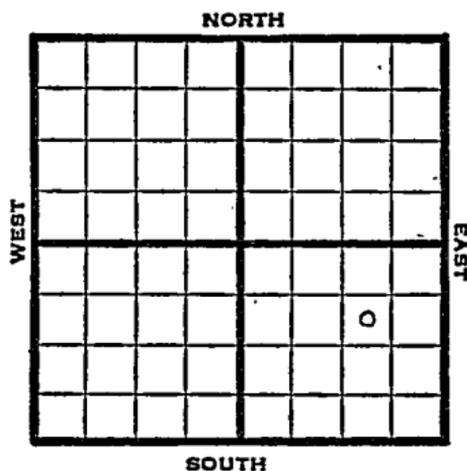

1950 Elev. 2098 REPORT

10/18 Location

1951
1/31

Spud 10/18/50
Oil well TD 3660
8" @1290
Lans. 3293 Arb. 3552
TD 3660
5" @3660 14/ 3633-38 FU 2450' water
4 1/2 hr. 14/3624-28 P/ 37 bo 275 bwpd
13/ 3617-20 250 A 63 bo 363 bw
24 hr. CO to 3616
21/ 3608-13 FU 25' oil 205' wtr.
13 hr. 250 A P/ 48 bo 430 bwpd
Comp. 42 bopd 92% water

COMPLETED

