


Section 26 Township 11 Range 17-W

Well No. 2 McCord

Company Cities Service Oil

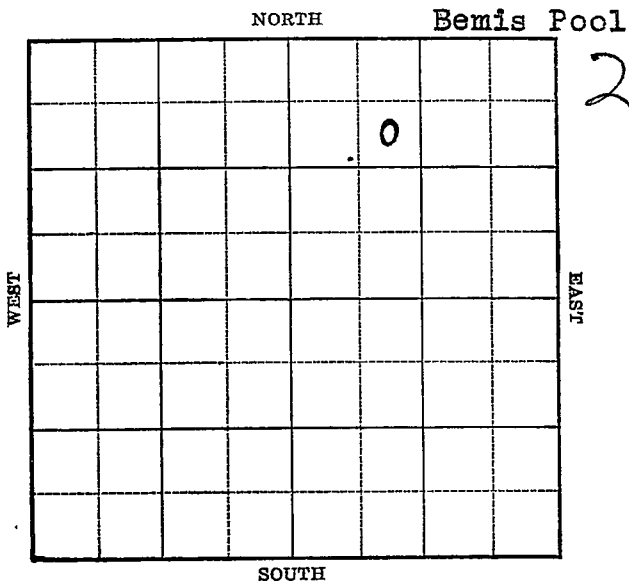

Sec. 26 Twp. 11 R. 17-W

Well No. #2 McCord Farm

Cities Service Oil Company


(Bemis)

990¹⁰⁴⁰ Ft. from N. Line

_____ Ft. from S. Line

_____ Ft. from E. Line

1140
990 Ft. from W. Line

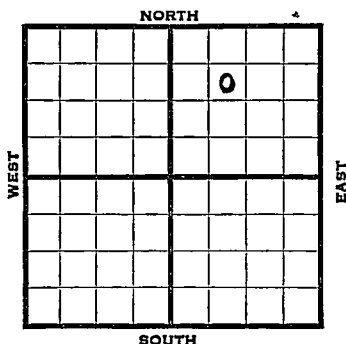

Elev. 2066

1939	REPORT
4/5	Location
4/14	Mat'l.
4/21	S. H.
4/28	8" - 1111' Drlg. 2363'
5/5	Drlg. 3440'
5/12	Arb. 3533' 5" - 3535'
	T.D. 3563' 1300' oil 18½ hrs.
	2000 acid.
5/17	Arb. 3533'
	5" - 3535'
	T.D. 3563'
	2000 acid.
	Potential 274 oil,
	Plus 4% water.
	COMPLETED

Map No. 71 Sec. 26 Twp. 11 R. 17WWell No. 2 McCordCities Service Oil Company

Contractor

FIRST REPORT

SECTION PLAT

SE NW NE

990 Ft. from N. Line

_____ Ft. from S. Line

_____ Ft. from E. Line

990 Ft. from W. Line

		0	

BEMIS POOL

Location X

Rig up _____

Drilling and Remarks:

RECORD

Cased _____ in., _____ ft.

Sand _____

Gas _____

Oil _____

Total Depth _____

PRODUCTION

1st 24 hrs. Nat. _____

1st 24 hrs. after shot _____

Gas _____ Cu. Ft.

Dry Hole _____

Abandoned _____

Date

APR 5 - 1930 19H. D. Hatfield Scout

Map No. 17 Sec. 26 Twp. 11 R. 17W

Well No. 2 McCord

Cities Service Oil Company

Contractor

COMPLETE

SECTION PLAT

1040 SE NW NE
Ft. from N. Line

_____ Ft. from S. Line

_____ Ft. from E. Line

1140 Ft. from W. Line

BEMIS POOL

		0	

Location _____

Rig up _____

Drilling and Remarks:

*Per. 3533
5" @ 3535
2000 acid
Per. 274 oil
plus 4% water*

RECORD

Cased _____ in., _____ ft.

Sand _____

Gas _____

Oil _____

Total Depth 3563

PRODUCTION

1st 24 hrs. Nat. _____

1st 24 hrs. after shot _____

Gas _____ Cu. Ft.

Dry Hole _____

Abandoned _____

Date

MAY 17 1939 19

S. J. LEWIS Scout

Map No. _____ Sec. 26 Twp. 11 R. 17W

Well No. 2 McGord

Cities Service Oil Company

CORRECTION Contractor

~~990~~ 1040 SE NW NE
Ft. from N. Line

_____ Ft. from S. Line

_____ Ft. from E. Line

~~990~~ 1140
Ft. from W. Line

BEMIS POOL

CORRECTION SECTION PLAT
CORRECTION
CORRECTION

		o	

Location _____

Rig up _____

Drilling and Remarks:

CORRECTION
*Corrected from
990 from N. line
and
990 from W. line*

RECORD

Cased _____ in., _____ ft.

Sand _____

Gas _____

Oil _____

Total Depth _____

PRODUCTION

1st 24 hrs. Nat. _____

1st 24 hrs. after shot _____

Gas _____ Cu. Ft.

Dry Hole _____

Abandoned _____

Date
MAY 17 1939 19

S. J. LEWIS Scout