Form 51—5M—11-38—Palace


Ellis

KANSAS

Section 26 Township 11 Range 17-W

Well No. #1 McCord

Company Cities Service Oil

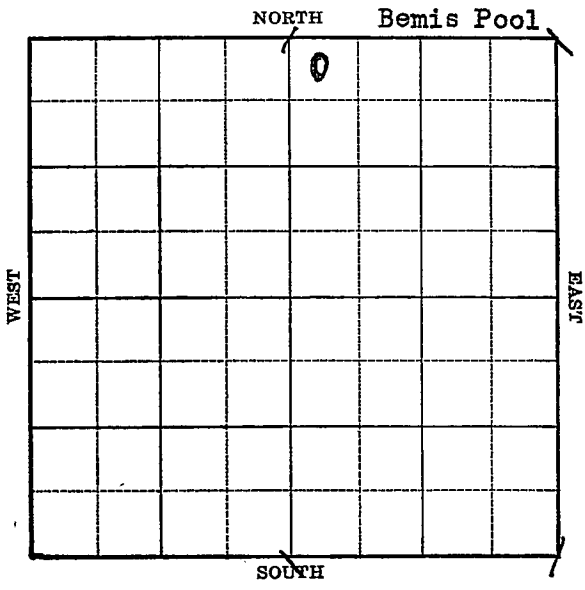

FORM 252-A 5M 10-38 KANSAS Ellis

Sec. 26 Twp. 11 R. 17-W

Well No. #1 McCord Farm

Cities Service Oil Company


(Bemis)

330 Ft. from N. Line

Ft. from S. Line

Ft. from E. Line

330 Ft. from W. Line

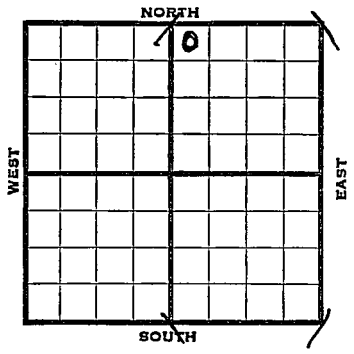

Elev. 2011

1939	REPORT
1/4	B.R.R.
1/13	10" - 992'.
	W.O.C.
1/20	Drlg. 2545'.
1/27	Drlg. 3420'.
2/3	Arb. 3476'. 7" - 3477'.
	T. D. 3487'. 3000' oil. C. O.
2/10	SD for tanks.
2/15	7" - 3477'
	Arb. 3476'.
	T. D. 3487'
	No acid.
	Well gauged by Echo-meter
	25,287 bbls. maximum potential
	Allowed when gauged this way
	3500 barrels.
	COMPLETED

Form 26—1M Bks.—2-29

Ellis KANSAS

Map No. 71 Sec. 26 Twp. 11 R. 17W

Well No. 1 McCord

Cities Service Oil Company

Contractor

FIRST REPORT

NW NE

330 Ft. from N. Line


_____ Ft. from S. Line

_____ Ft. from E. Line

330 Ft. from W. Line

BEMIS POOL

SECTION PLAT

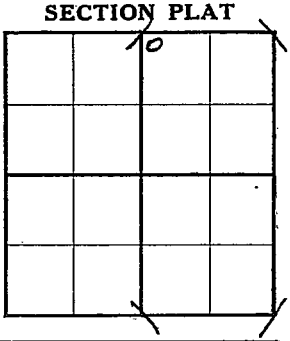

Location _____

Rig up _____

Drilling and Remarks:

BRR

RECORD

Cased _____ in., _____ ft.

Sand _____

Gas _____

Oil _____

Total Depth _____

PRODUCTION

1st 24 hrs. Nat. _____

1st 24 hrs. after shot _____

Gas _____ Cu. Ft.

Dry Hole _____

Abandoned _____

Date

JAN 4 - 1938 19 ____ T. D. Hatfield Scout

Form 26—1M Bks.—2-29

Ellis KANSAS

Map No. Sec. 26 Twp. 11 R. 17W

Well No. 1 McCord

Cities Service Oil Company

Contractor

COMPLETED

NW NE

330 Ft. from N. Line


Ft. from S. Line

Ft. from E. Line

330 Ft. from W. Line

BEMIS POOL

SECTION PLAT

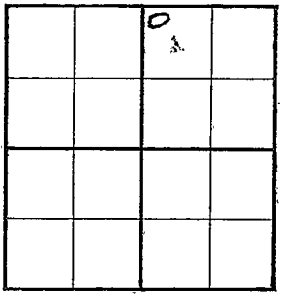

Location

Rig up

Drilling and Remarks:

No Acid
well guaged by
Echo-meter = 25,287 bbls
Maximum P.O.T. allowed
when gauged this way
is = 3500 bbls

RECORD

Cased 7 in., 3477 ft.

Sand Arb 3476

Gas

Oil

Total Depth 3487

PRODUCTION

1st 24 hrs. Nat.

1st 24 hrs. after shot

Gas Cu. Ft.

Dry Hole

Abandoned

Date

FEB 15 1939 19

H. D. Hatfield Scout