KANSAS


Form 51—5M—7-39—Palace

Ellis

Section 26 Township 11 Range 17-W

Well No. #3 McCord

Company Cities Service Oil

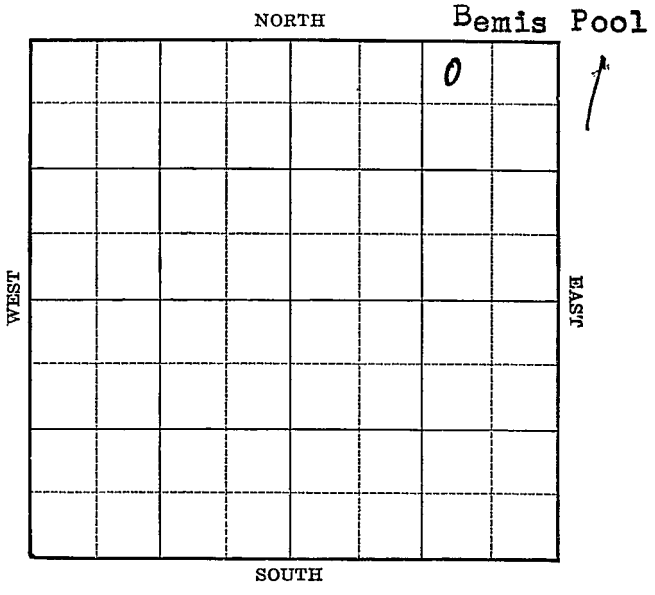

FORM 252-A 5M 2-40

KANSAS Ellis

Sec. 26 Twp. 11 R. 17-W

Well No. #3 McCord Farm

Cities Service Oil Company

(Bemis)


330 Ft. from N. Line

Ft. from S. Line

990 Ft. from E. Line

Ft. from W. Line

Elev. 2057

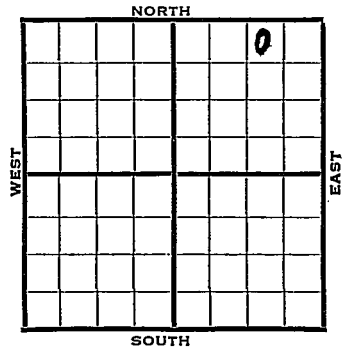

1940	REPORT
4/17	Location
4/25	"
5/2	R.U.R.
5/9	8" - 1085'
	Drlg. 2311'
5/15	Drlg. 3340'
5/23	Arb. 3522-24' T.D. 5" - 3523'
	RUST.
5/29	Arb. 3522'
	5" - 3523'
	T.D. 3528'
	1000 acid.
	Echometer potemtial 14,728 bbls.
	Maximum 3000 bbls.
	COMPLETED

Form 26—200 Bks.—1-40—Palace Ellis KANSAS

Map No. 7/ Sec. 26 Twp. 11 R. 17W

Well No. 3 McCord

Cities Service Oil Company

Contractor

FIRST REPORT

NW NE NE

330 Ft. from N. Line


Ft. from S. Line

990 Ft. from E. Line

Ft. from W. Line

BEMIS POOL

SECTION PLAT

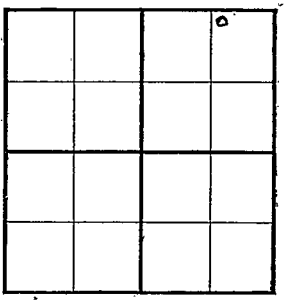

Location X

Rig up

Drilling and Remarks:

RECORD

Cased in., ft.

Sand

Gas

Oil

Total Depth

PRODUCTION

1st 24 hrs. Nat.

1st 24 hrs. after shot

Gas Cu. Ft.

Dry Hole

Abandoned

Date

APR 17 1940 19

S. J. LEWIS Scout

KANSAS

Form 26—200 Bks.—1-40—Palace Ellis

Map No. 71 Sec. 26 Twp. 11 R. 17W

Well No. 3 McCord

Cities Service Oil Company

Contractor

COMPLETED

NW NE NE

330 Ft. from N. Line


Ft. from S. Line

990 Ft. from E. Line

Ft. from W. Line

BEMIS POOL

SECTION PLAT

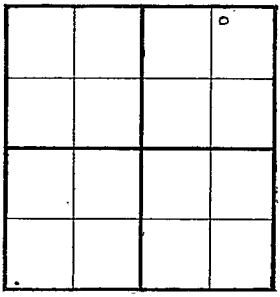

Location

Rig up

Drilling and Remarks:

Cr & 3522.
5' C 3523
1000 Acid
Echometer R.T.
1472 8'

Maximum 3008

RECORD

Cased in., ft.

Sand

Gas

Oil

Total Depth 3528'

PRODUCTION

1st 24 hrs. Nat.

1st 24 hrs. after shot

Gas Cu. Ft.

Dry Hole

Abandoned

Date

MAY 29 1940 19

S. J. LEWIS Scout