



KANSAS

*Sugo*  
*23W*

Map No. \_\_\_\_\_ Sec. 26 Twp. 11 R. \_\_\_\_\_

Well No. 1- ~~Lowy~~ Holcomb Farm \_\_\_\_\_

Continental Oil Company \_\_\_\_\_


1320 Ft. from N. Line

\_\_\_\_\_ Ft. from S. Line

440 Ft. from E. Line

\_\_\_\_\_ Ft. from W. Line

Elev. 2355

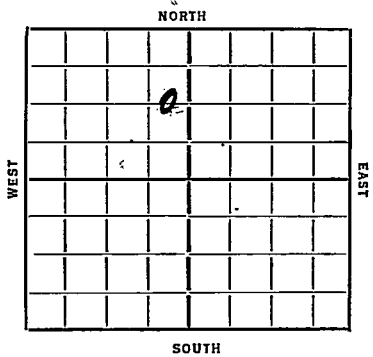

REPORT

<u>1936</u>	
<u>1/29</u>	<u>Location</u>
<u>2/7</u>	
<u>2/14</u>	<u>Rgn</u>
<u>2/21</u>	
<u>2/28</u>	<u>Spud</u>
<u>3/6</u>	<u>Blg 1367</u>
<u>3/13</u>	<u>" 2370 15" 177</u>
<u>3/20</u>	<u>Drlg. 3125</u>
<u>3/27</u>	<u>T. <math>\frac{1}{2}</math> opeka 3210 <math>\frac{1}{2}</math> op oswega 3595</u>
	<u>7"-3598 T.D. 3603'</u>
<u>4/2</u>	<u>Rust.</u>
<u>4/8</u>	<u>Oswald lime Pay 3647-54</u>
	<u>1500 feet oil 24 hrs. (Telegram)</u>
<u>4/16</u>	<u>4000 acid- 439bbls. in 23 hours.</u>
<u>4/23</u>	<u>R Testing.</u>
<u>4/29</u>	<u>/36- Top Oswald 3595'</u>
	<u>Pay 3647'-54' T.D. 3654'</u>
	<u>4000 acid.</u>
	<u>Pump 616 bbls.</u>
	<u>Trace of water.</u>

COMPLETED

Map No. 69 Sec. 26 Twp. 11 R. 23W

Well No. 1-Cave

Continental Oil Company

Contractor

### FIRST REPORTS

1320 Ft. from N. Line

..... Ft. from S. Line

440 Ft. from E. Line

..... Ft. from W. Line

### SECTION PLAT

	o		

Location

Rig up .....

Drilling and Remarks:

### RECORD

Cased..... in., ..... ft.

Sand.....

Gas.....

Oil.....

Total Depth.....

### PRODUCTION

1st 24 hrs. Nat.....

1st 24 hrs. after shot.....

Gas..... Cu. Ft.

Dry Hole.....

Abandoned.....

Date

1-29-36 192.....

ORVAL MANNSCHRECK

Scout

Map No. 69 Sec. 26 Twp. 11 R. 23W

Well No. 1 - Holcomb

Continental Company

Contractor

CORRECTION

SECTION PLAT

1320 Ft. from N. Line *CEL NW*

..... Ft. from S. Line

440 Ft. from E. Line

..... Ft. from W. Line

	○		

CORRECTION

Location Cellar

Rig up.....

Drilling and Remarks:

*was not reported  
as #1 - cave*

RECORD

Cased.....in., .....ft.

Sand.....

Gas.....

Oil.....

Total Depth.....

PRODUCTION

1st 24 hrs. Nat.....

1st 24 hrs. after shot.....

Gas.....Cu. Ft.

Dry Hole.....

Abandoned.....

Date

FEB 5 1936

ORVAL MANNSCHRECK

192.....Scout

Map No. 69 Sec. 26 Twp. 11 R. 23 W

Well No. 1 Holcomb

Continental Company

Contractor

SECTION PLAT


1820 Ft. from N. Line

..... Ft. from S. Line

440 Ft. from E. Line

..... Ft. from W. Line

COMPLETED

RECORD

Location.....

Rig up.....

Drilling and Remarks:

Top Drive 3096

Pay 3647-54

4000 acid

Pump 6168 ft

Thence west 28

Cased..... in., ..... ft.

Sand.....

Gas.....

Oil.....

Total Depth 3654

PRODUCTION

1st 24 hrs. Nat.....

1st 24 hrs. after shot.....

Gas..... Cu. Ft.

Dry Hole.....

Abandoned.....

Date

APR 29 1923

S. J. LEWIS