



**KANSAS**

Map No. \_\_\_\_\_ Sec. 26 Twp. 11 R. 23-W

Well No. 1- F. Holcomb Farm \_\_\_\_\_

Continental Company


1320 Ft. from N. Line

\_\_\_\_\_ Ft. from S. Line

\_\_\_\_\_ Ft. from E. Line

440 Ft. from W. Line

Elev. 2360

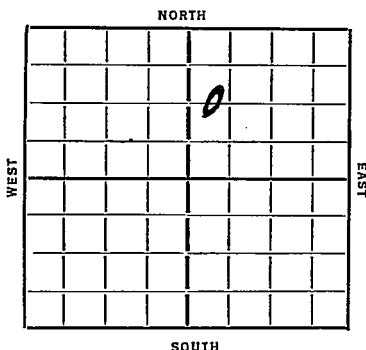

Date 1936	REPORT
4/8	Location
4/16	Bonds.
4/23	Rigging up.
4/30	Run 10" @ 1135'
5/7	Drlg. 2160'.
5/14	Drlg. 3010'.
5/21	Lansing 3610'. 6" @ 3614'.
5/28	T.D. 3615'. RUST.
6/4	S.D.
6/11	Pay 3660-61'. 1150' oil in 24 hours
6/11	Drlg. 3663'-2200' oil in hole.
7/8/36	T.D. 3665' building tanks.
7/8/36	-Lansing 3610'.
7/8/36	Water 3680-81'. T.D. 3681'.
7/8/36	P.B. 3679'.
7/8/36	4000 gallons of acid.
7/8/36	495 bbls of oil and 40 bbls of
7/8/36	water in 22 hours.
7/8/36	<b>COMPLETED</b>

**KANSAS**

Map No. 69 Sec. 26 Twp. 11 R. 28 W

Well No. 1 F. Holcomb

Continental Company

Contractor

**SECTION PLAT**

1320 Ft. from N. Line

..... Ft. from S. Line

..... Ft. from E. Line

440 Ft. from W. Line

		0	

**FIRST REPORT**

Location

Rig up

Drilling and Remarks:

**RECORD**

Cased.....in., .....ft.

Sand.....

Gas.....

Oil.....

Total Depth.....

**PRODUCTION**

1st 24 hrs. Nat.....

1st 24 hrs. after shot.....

Gas.....Cu. Ft.

Dry Hole.....

Abandoned.....

Date

4/8/26 192.....

J. J. LEWIS

Scout

KANSAS

Map No. 69 Sec. 26 Twp. 11 R. 23W

Well No. 1 Holcom & "A"

Continental Company

Contractor

SECTION PLAT

		0	

1820 Ft. from N. Line

\_\_\_\_\_ Ft. from S. Line

\_\_\_\_\_ Ft. from E. Line

440 Ft. from W. Line

COMPLETED

Location \_\_\_\_\_

Rig up \_\_\_\_\_

Drilling and Remarks:

*Learning 3610*  
*Water 3080-81*  
*P.B. 3679*  
*4000 acid*  
*495 oil 40 water*  
*22 hrs*

RECORD

Cased \_\_\_\_\_ in., \_\_\_\_\_ ft.

Sand \_\_\_\_\_

Gas \_\_\_\_\_

Oil \_\_\_\_\_

Total Depth 3681

PRODUCTION

1st 24 hrs. Nat. \_\_\_\_\_

1st 24 hrs. after shot \_\_\_\_\_

Gas \_\_\_\_\_ Cu. Ft.

Dry Hole \_\_\_\_\_

Abandoned \_\_\_\_\_

Date

JUL 8 1936

19

S. J. LEWIS

Scout