


HAVE
Save Log

KANSAS CORPORATION COMMISSION

WELL RECORD

28-11-26W

(Mail to Kansas Geological Survey, 4150 Monroe Street, Wichita, Kansas 67209)

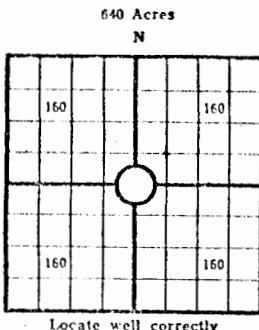

Lease Name: Bedard Well No. 1
Well Located: Gove County
SE SE NW SEC 28 TWP 11S RGE 26W
Operator: Herndon Drilling Co.
Address: Box 489, Tulsa, Oklahoma 74101
Elevation: Ground 2657 D.F. 2662 K.B.
Type Well: (Oil, gas, dry hole) Dry Hole

Drilling Commenced: 11-30- 1971 Drilling Completed: 12-4- 1971
Well Completed: 12-4- 1971 Total Depth 2890
Initial Production: _____

Casing Record

Size: 8 5/8" Set at 207 Size: _____ Set at _____
Size: _____ Set at _____ Size: _____ Set at _____

Liner Record

Size: _____ Set from _____ To _____

Cementing

<u>Casing Size</u>	<u>Sacks</u>	<u>Type Cement and Additives</u>
<u>8 5/8"</u>	<u>175</u>	_____
_____	_____	_____
_____	_____	_____

Perforations

Formation Perforated Interval and Number Shots

Electric Log Run (Show type log and depths covered)

GAMMA 1900-2417

SHOW DRILL STEM Tests, *cont.*
Well Stimulation and
Production Tests

28-11-26w

Formation Top Bottom

Anyhydrite	2253	
Base		2293
T. D.		2890
		Shale & Sand 0 780
		Shale 780 1330
		Shale & Sand 1330 2255
		Shale & Shells 2330 2560
		Shale & Lime 2560 2860
		Lime & Shale 2860 2890
		R.T.D. 2890

t8t86