


Russell

KANSAS

SECTION 27 TOWNSHIP 11 RANGE 15W

WELL NO. #1 Eulert

COMPANY Petroleum Inc.

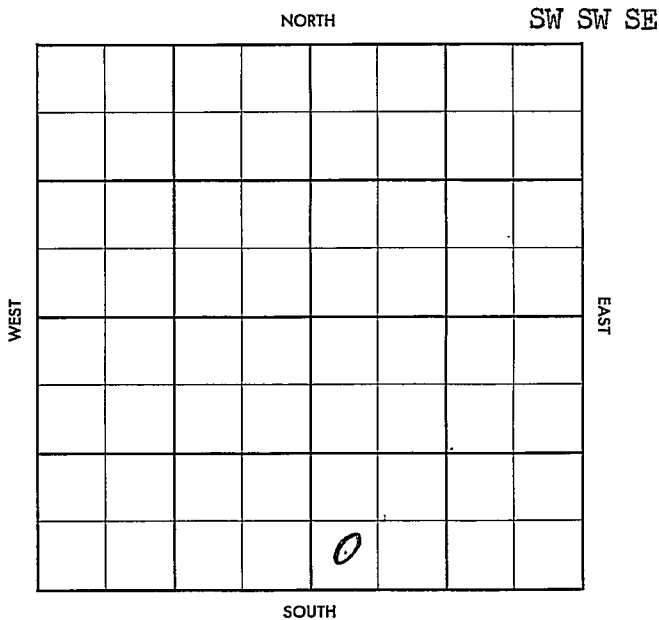

1733 DF

County Russell Elev. 1735 RB
 Sec. 27 Twp. 11 Rge. 15W
 Company Petroleum Inc.
 Farm Name Eulert No. 1

TOPS	DEPTH	LOG	DATUM	Loc. in Sec.
Anh.	810			SW SW SE
Tp.	2584			
H.	2838			
Tr.	2861			
Dg.				
Bl.				
L.	2891			Geol.
K.C.				Contr.
B.K.C.				Garvey Tools
Ce.				Pool
C.	3205			Fairport
M.				
M.				
K.				
Mz.				
Ma.				
V.				
S.				
S.				
A	3210			ABANDONED JUL 3 '57
R.				
Pe.				
G.				
T.D.	3250			

Date Comm. 6-20-57

8" @ 198/150, Drlg. 2645 " DST
 2600-60 1hr rec 30' Md
 BHP 175' 20" DST 2773-2825
 1hr rec 150' WM BHP 1000
 120" DST 2961-68 1hr rec
 108' WM BHP 620 120" DST
 2984-3100 1hr rec 420' MSW
 BHP 710 120" DST 3199-3214 1hr
 rec 12' Md BHP 0 DST 3214-22