

KANSAS

Section 27 Township 11 Range 18W

Well No. #2 Henderson "G"

Company Mazda Oil

NORTH

0							

5

WEST

EAST

SOUTH

PPHIGAS

Ellis

✓

Sec. 27 Twp. 11 R. 18W

Well No. #2 Henderson "G" Farm

Mazda Oil Company

Burnett Pool


Ft. from N. Line

990' Ft. from S. Line

Ft. from E. Line

330' Ft. from W. Line

NW SW NW

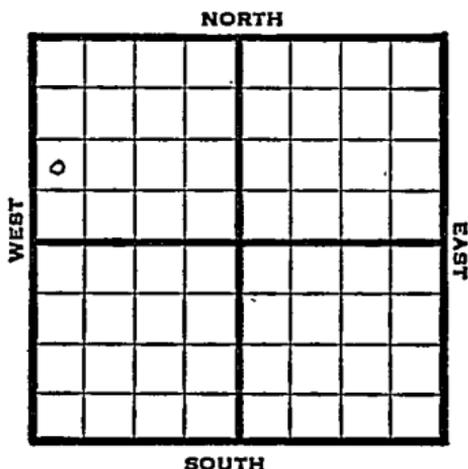

1948

Elev. 2007'

REPORT

- 5/19 Drlg. 770'
- 5/26 8" @ 1285'
Drlg. 2790'
- 6/1 Lansing 3232'
Drlg. 3330'
- 6/9 Arb. 3526'
5" @ 3528'
250 acid
Depth Pot 3000 oil
Gr. 36.7
TD 3534'
Comp.

COMPLETED

Map No. _____ Sec. 27 Twp. 11 R. 18W

Well No. 2 Henderson "G"

Mazda Oil _____ Company

FIRST REPORT

Contractor _____

NW SW NW

SECTION PLAT

_____ Ft. from N. Line

990 Ft. from S. Line

_____ Ft. from E. Line

330 Ft. from W. Line

o			

Ellis County

Location _____

Rig up _____

Drilling and Remarks:

drlg. 770

RECORD

Cased _____ in., _____ ft.

Sand _____

Gas _____

Oil _____

Total Depth _____

PRODUCTION

1st 24 hrs. Nat. _____

1st 24 hrs. after shot _____

Gas _____ Cu. Ft.

Dry Hole _____

Abandoned _____

Date

MAY 19 1948 19 S. J. LEWIS Scout

Map No. 71 Sec. 27 Twp. 11 R. 18W

Well No. 2 Henderson "G"

Ma, da Oil Company

COMPLETE

Contractor

NW SWNW

E. 2007

SECTION PLAT

_____ Ft. from N. Line

990 Ft. from S. Line

_____ Ft. from E. Line

330 Ft. from W. Line

o			

Ellis County

Location _____

Rig up _____

Drilling and Remarks:

26 x 3526
5' @ 3528
25000 oil
Depth to 3000 oil
2624

RECORD

Cased _____ in., _____ ft.

Sand _____

Gas _____

Oil

Total Depth 3524

PRODUCTION

1st 24 hrs. Nat. _____

1st 24 hrs. after shot _____

Gas _____ Cu. Ft.

Dry Hole _____

Abandoned _____

Date

JUN 9 1948 19

S. J. LEWIS Scout