


Section 27 Township 11 Range 18W

Well No. 3 Henderson "G"

Company Mazda Oil

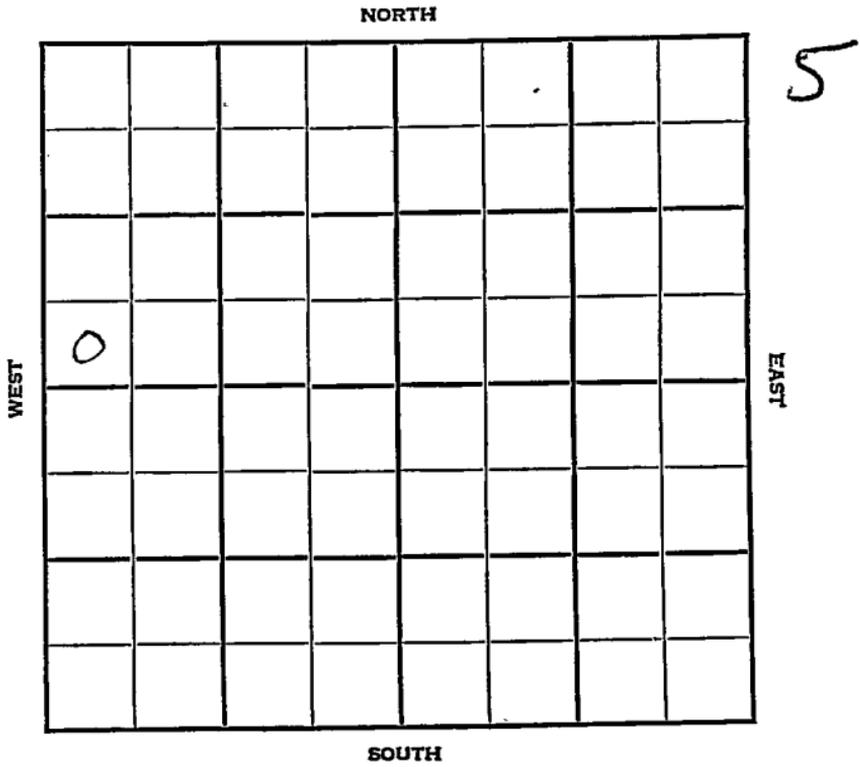



Sec. 27 Twp. 11 R. 18-W

Well No. #3 Henderson "G" Farm

Mazda Oil Company

Burnett Pool


 Ft. from N. Line

330 Ft. from S. Line

 Ft. from E. Line

330 Ft. from W. Line

SW NW

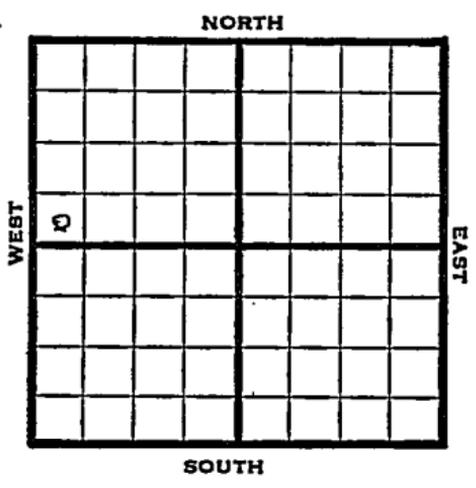

1948

Eli 2079'

R E P O R T

8/11

Location

8/18

Drlg 1124

8/25

8" @ 1363'
Drlg 1890'

9/1

Drlg. 3194'

9/8

Arb. 3597'
TD 3605'
5" @ 3597'

9/15

Swb 15 bbls oil PH
Arb. 3597'
5" @ 3597'
TD 3605'
500 acid
Pump 50 oil Pot
36°n Gr.
Comp

COMPLETED

Ellis County Kansas State

Map No. 71 Sec. 27 Twp. 11 R. 18W

Well No. 3 Henderson "G"

Mazda Oil Company

COMPLETE

Contractor

E. 2079

SW NW

SECTION PLAT

 Ft. from N. Line

330 Ft. from S. Line

 Ft. from E. Line

330 Ft. from W. Line

Burnett Pool

Remarks:

Art 3597

5" 3597

7FD 3605




Date
SEP 15 1948

Scout **S. J. LEWIS**