

KANSAS

Ellis

Section 27 Township 11 Range 18WWell No. 4 Henderson "G"Company Mazda Oil

Burnett Pool

NORTH

		0					

WEST

EAST

SOUTH

6

KANSAS

Ellis

Sec. **27** Twp. **11** R. **18W**

Well No. **#4 Henderson "G"** Farm

Mazada Oil

Company

Burnett Pool

Ft. from N. Line

330'


Ft. from S. Line

990'

Ft. from E. Line

Ft. from W. Line

SW SE NW

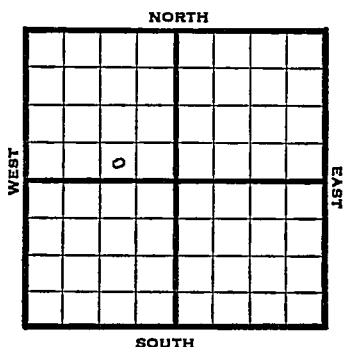

1948

Elev. 2094' REPORT

9/15

Surface Hole

9/21

8" @ 1380'

Drlg 2283'

9/29

Lansing 3331'

Drlg 3468'

10/6

Arb. 3626'

TD 3632

5" @ 3626

1600' oil 4 hrs.

10/13

Arb. 3626'

5" @ 3626

250 acid

Echo Pot.

3000 oil

Gr. 36°

TD 3632'

COMPLETED

Ellis County Kansas State

Map No. _____ Sec. 27 Twp. 11 R. 18W

Well No. 4 Henderson "G"

Mazda Oil Company

FIRST REPORT

Contractor _____

SW SE NW

SECTION PLAT

_____ Ft. from N. Line

330 Ft. from S. Line

990 Ft. from E. Line

_____ Ft. from W. Line

Burnett Pool

Remarks:

surface hole

Date
SEP 15 1948

Scout
S. J. LEWIS

Kansas

Burnett Pool

Map No. 71 Sec. 27 Twp. 11 R. 18WWell No. 4 Henderson "G"

Mazda Oil

Company


COMPLETE

Contractor

SW SE NW

21,2094

SECTION PLAT

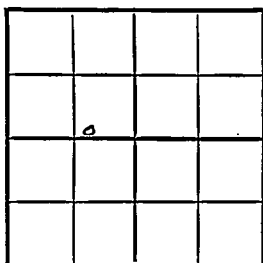

Ft. from N. Line

330 Ft. from S. Line

990 Ft. from E. Line

Ft. from W. Line

Ellis County

RECORD

Location

Cased in ft.

Rig up

Sand

Drilling and Remarks:

Gas

288626

Oil

5" @ 8626

Total Depth 3832

200 @ 8626

PRODUCTION

1st 24 hrs. Nat.

Ec 1st 24

1st 24 hrs. after shot

8000 oil

Gas Cu. Ft.

36-2

Dry Hole

Abandoned

Date

OCT 13 1948

S. J. LEWIS Scout