


KANSAS

Ellis

Section 27 Township 11 Range 18-W

Well No. #2 Henderson "H"

Company Mazda Oil
Burnett Pool

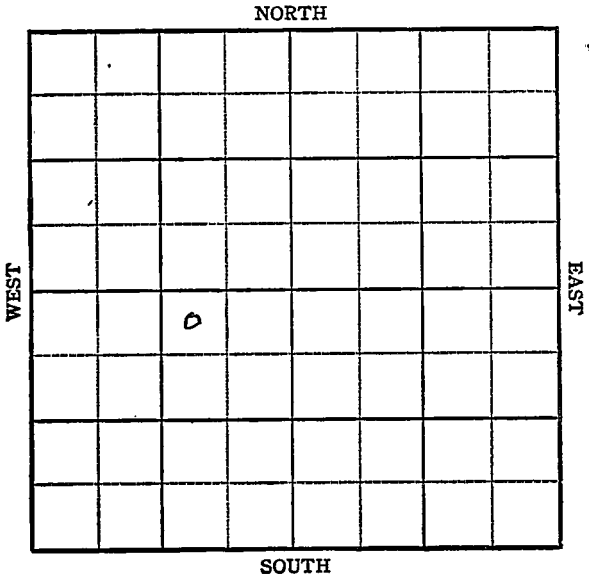

KANSAS

Ellis

Sec. 27 Twp. 11 R. 18W

Well No. #2 Henderson "H" Farm

Mazda Oil

Company

Burnett Pool


330' Ft. from N. Line

Ft. from S. Line

990' Ft. from E. Line

Ft. from W. Line

NW NE SW

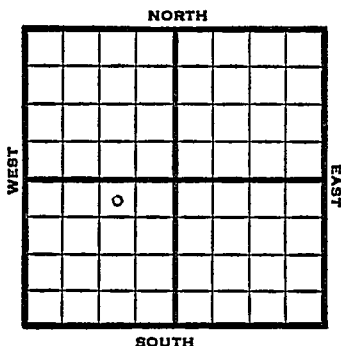

1948

Eli 2108'

REPORT

12/8

Drlg. 1320'

12/15

Drlg 2295'

12/22

8" @ 1383'
Lansing 3372'

12/29

Drlg 3460'
TD 3755 in Cong
Lans 3372'
Cong 3653'
Aband.

ABANDONED

Map No. _____ Sec. 27 Twp. 11 R. 18W

Well No. 2 Henderson "H"

Mazda Oil Company

FIRST REPORT Contractor

NW NE SW


SECTION PLAT

330 Ft. from N. Line

_____ Ft. from S. Line

990 Ft. from E. Line

_____ Ft. from W. Line

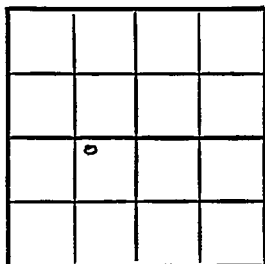

Ellis County

Location _____

Rig up _____

Drilling and Remarks:

drlg. 1320

RECORD

Cased _____ in., _____ ft.

Sand _____

Gas _____

Oil _____

Total Depth _____

PRODUCTION

1st 24 hrs. Nat. _____

1st 24 hrs. after shot _____

Gas _____ Cu. Ft.

Dry Hole _____

Abandoned _____

Date

DEC 8 1948 19 S. J. LEWIS Scout

Map No. 71 Sec. 27 Twp. 11 R. 18W

Well No. 2 Henderson "H"

Mazda Oil Company

ABANDONED

Contractor

NW NE SW


E 12108
SECTION PLAT

330 Ft. from N. Line

 Ft. from S. Line

990 Ft. from E. Line

 Ft. from W. Line

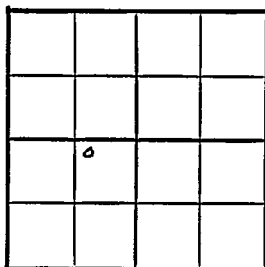

Ellis County

Location

Rig up

Drilling and Remarks:

lane 3822
Cong 3653

RECORD

Cased in., ft.

Sand

Gas

Oil

Total Depth 3755 in Cong

PRODUCTION

1st 24 hrs. Nat.

1st 24 hrs. after shot

Gas Cu. Ft.

Dry Hole

Abandoned

Date

DEC 29 1948

19

S. J. LEWIS

Scout