

Section 27 Township 11 Range 18-W

Well No. #3 Henderson "G"

Company Mazda Oil

Burnett Pool NORTH

0							

WEST EAST SOUTH

12

KANSAS

Sec. 27 Twp. 11 R. 18W

Well No. #3 Henderson "G" Farm

Mazda Oil Company

Burnett Pool


330' Ft. from N. Line

_____ Ft. from S. Line

_____ Ft. from E. Line

330' Ft. from W. Line

NW SW

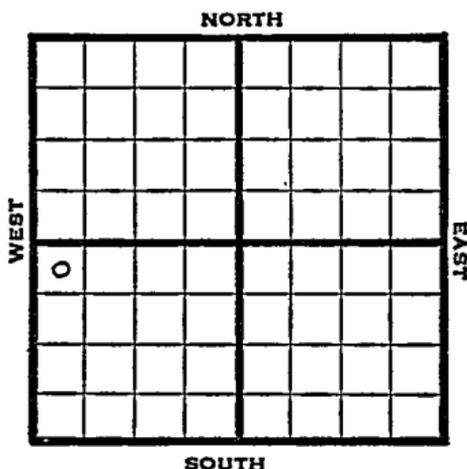

1948 REPORT

6/30 Location

7/8 Location

ABANDONED

Map No. 71 Sec. 27 Twp. 11 R. 18W

Well No. 3 Henderson "G"

Mazda Oil Company

ABANDONED Contractor

NW SW

SECTION PLAT

330 Ft. from N. Line

_____ Ft. from S. Line

_____ Ft. from E. Line

330 Ft. from W. Line

0			

Ellis County

Location ✓

Rig up _____

Drilling and Remarks:

RECORD

Cased _____ in., _____ ft.

Sand _____

Gas _____

Oil _____

Total Depth _____

PRODUCTION

1st 24 hrs. Nat. _____

1st 24 hrs. after shot _____

Gas _____ Cu. Ft.

Dry Hole _____

Abandoned _____

Date

JUL 8 1948 19_____

S. J. LEWIS Scout

Map No. _____ Sec. 27 Twp. 11 R. 18W

Well No. 3 Henderson "H"

Madza Oil _____ Company

FIRST REPORT _____ Contractor

NW SW

SECTION PLAT

330 Ft. from N. Line

_____ Ft. from S. Line

_____ Ft. from E. Line

330 Ft. from W. Line

o			

Ellis County

Location X

Rig up _____

Drilling and Remarks:

RECORD

Cased _____ in., _____ ft.

Sand _____

Gas _____

Oil _____

Total Depth _____

PRODUCTION

1st 24 hrs. Nat. _____

1st 24 hrs. after shot _____

Gas _____ Cu. Ft.

Dry Hole _____

Abandoned _____

Date

JUL 21 1948

19

S. J. LEWIS

Scout