

KANSAS

Section 27 Township 11 Range 18<sup>SW</sup>

Well No. #1 Henderson "H"  
#3 Henderson "G"

Company Mazda Oil

NORTH

	0						

13

WEST

EAST

SOUTH

KANSAS

Ellis

Sec. 27 Twp. 11 R. 18W

Well No. #1 ~~#3~~ Henderson "H" Farm

Madza Oil

Company

Burnett Pool


330' Ft. from N. Line

\_\_\_\_\_ Ft. from S. Line

\_\_\_\_\_ Ft. from E. Line

330' Ft. from W. Line

NW SW

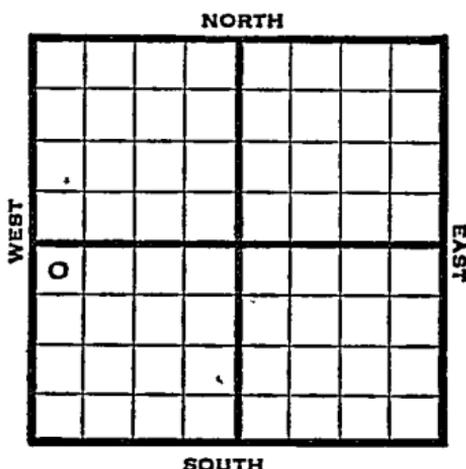

1948

Eli 2082'

REPORT

7/21  
7/28

Location  
8" @ 1250'  
WOC

8/4  
8/11

Drig. 2945'  
Lansing 3314'  
Simpsong 3588'  
Arbuckle 3605-17  
TD 3617'  
5" @ 3605'

8/18

Arbuckle 3605'  
5" @ 3605'  
TD 3617'  
500 acid  
Echo Pot 3000 oil  
36° Gr.  
Comp

**COMPLETED**

Map No. \_\_\_\_\_ Sec. 27 Twp. 11 R. 18W

Well No. 3 Henderson "G"

Mazda Oil Company

**FIRST REPORT** Contractor \_\_\_\_\_

NW SW

SECTION PLAT

330 Ft. from N. Line

\_\_\_\_\_ Ft. from S. Line

\_\_\_\_\_ Ft. from E. Line

330 Ft. from W. Line

o			

Ellis County

Location x

Rig up \_\_\_\_\_

Drilling and Remarks:

RECORD

Cased \_\_\_\_\_ in., \_\_\_\_\_ ft.

Sand \_\_\_\_\_

Gas \_\_\_\_\_

Oil \_\_\_\_\_

Total Depth \_\_\_\_\_

PRODUCTION

1st 24 hrs. Nat. \_\_\_\_\_

1st 24 hrs. after shot \_\_\_\_\_

Gas \_\_\_\_\_ Cu. Ft.

Dry Hole \_\_\_\_\_

Abandoned \_\_\_\_\_

Date

JUN 30 1948 19

S. J. LEWIS Scout



Ellis County Kansas State

Map No. 71 Sec. 27 Twp. 11 R. 18W

Well No. 1 Henderson "H"

Mazda Oil Company

**COMPLETE**

Contractor

NW SW

*E1,2082*  
SECTION PLAT

330 Ft. from N. Line

\_\_\_\_\_ Ft. from S. Line

\_\_\_\_\_ Ft. from E. Line

330 Ft. from W. Line


Burnett Pool

Remarks:

*CU # 3605*

*5" @ 3605*

*778617*

*500 Acid*

*Eckert # 3000 bit*

*3605*

Date

AUG 18 1948

Scout

S. J. LEWIS