

KANSAS


FORM 51 5M 6-46 PETROL

Ellis county

Section 27 Township 11 Range 18-W

Well No. #2, Henderson

Company Mazda Oil Company

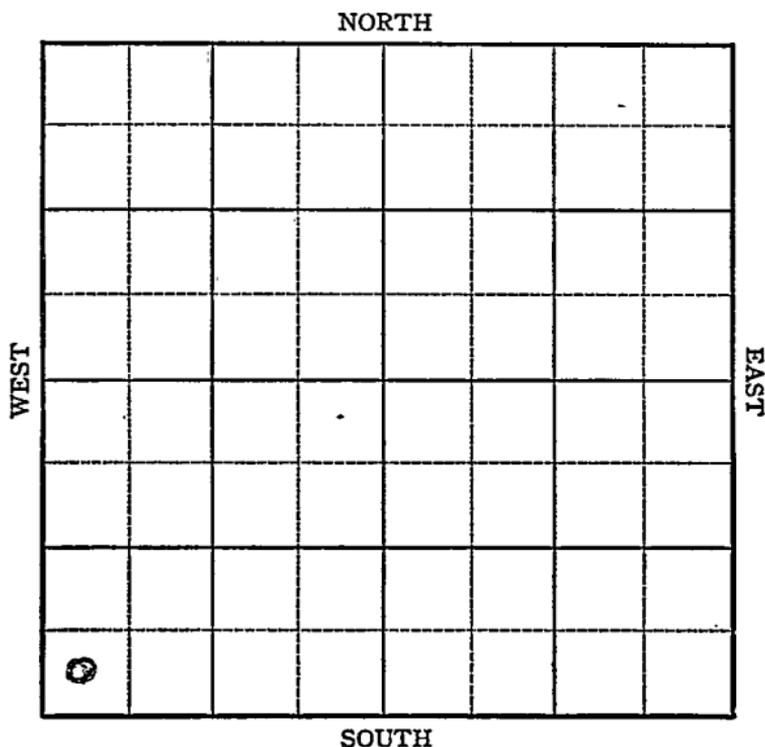

KANSAS

Ellis ⁶ ✓

Sec. 27 Twp. 11 R. 18W

Well No: 2 Henderson Farm

Mazda Oil Company

Burnett


Ft. from N. Line

330 Ft. from S. Line

Ft. from E. Line

330 Ft. from W. Line

SW/C

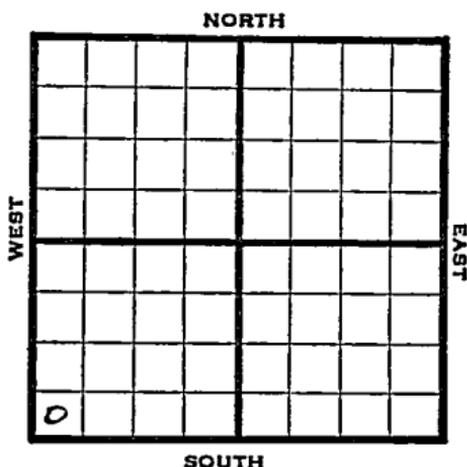

1946 Elev. 2095' REPORT

11/20	Location
11/27	RUR
12/3	Anhy 1392' Drlg 2500'
12/10	Anhy 1392' 8" @ 1400' Ilopeka 3070' Lans 3364' Drlg 3443'
12/18	Arb 3702' TD 3735'

ABANDONED

Map No. 71 Sec. 27 Twp. 11 R. 18W

Well No. 2 Henderson

Mazda Oil Company

FIRST REPORT Contractor

SW/C

SECTION PLAT

 Ft. from N. Line

330 Ft. from S. Line

 Ft. from E. Line

330 Ft. from W. Line

Ellis County

Location X

Rig up

Drilling and Remarks:

RECORD

Cased in., ft.

Sand

Gas

Oil

Total Depth

PRODUCTION

1st 24 hrs. Nat.

1st 24 hrs. after shot

Gas Cu. Ft.

Dry Hole

Abandoned

Date

NOV 20 1946

19

S. J. LEWIS Scout

