


Section 27 Township 11 Range 19 W

Well No. # 3 Vine "C"

Company Skelly Oil

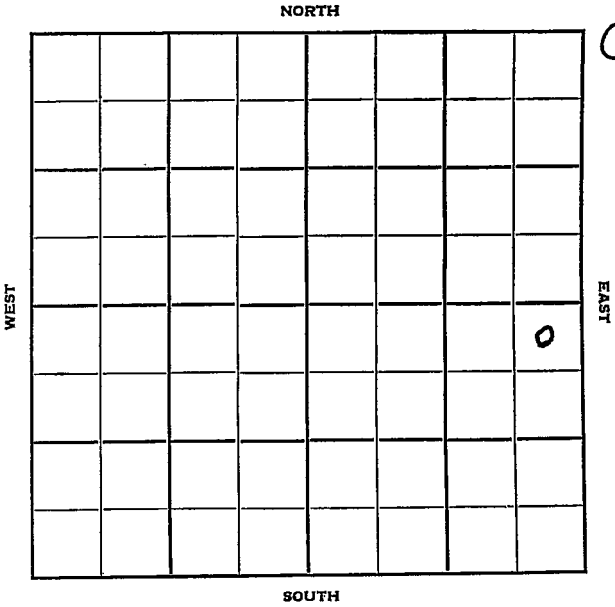



Sec. 27 Twp. 11 R. 19 W

Well No. # 3 Vine "C" Farm

Skelly Oil Company

Contractor

Solomon Pool


330 Ft. from N. Line

_____ Ft. from S. Line

330 Ft. from E. Line

_____ Ft. from W. Line

NE NE SE

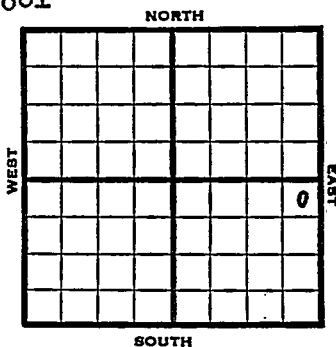

1953 Elev. 2050' REPORT

6/17 Location
 6/24 Anhy 1347 8" @ 1357
 Drlg. 2350'
 7/1 Heeb 3233, Tor 3252, Lans 3273,
 Cong 3518, Simp 3544, Arb 3558
 RTD 3564
 5" @ 3559
 7/8 Spud 6-15-53
 Oil Well
 TD 3572'
 Anhy 1347'
 8" @ 1357'
 Heeb 3233', Tor 3252, Lans 3273,
 Cong 3518, Simp 3544, Arb 3558
 TD 3564'
 5" @ 3559'
 DP 3564'
 FU 300' oil 4 hr. DD 3572
 FU 1500' oil 15 hr.
 P/.100 bo 4 bw 13 hr.
 Comp. 109 bopd 4% wtr.

COMPLETED

County Ellis State Kansas

Sec. 27 (Blk. 11) (Sur. 19W) (Twp.) (Rge.) Map No.

Operator Skelly Oil

Well No. 3 Farm Vine "C"

Elev. 2050 Location NE NE SE

330 Ft. From N Line SE

330 Ft. From E Line Quarter

Ist. Report

Completion JUL 8 1953

Remarks Solomon Pool

Spudding Date 6-15-53

Drlg. Data Oil well TD 3572

Anhy 1347 8" @ 1357 Heeb. 3233

Tor. 3252 Lans. 3273 Cong. 3518

Simp. 3544 Arb. 3558 TD 3564

5" @ 3559 DP 3564 FU 300' oil 4 hr.

DD 3572 FU 1500' oil 15 hr.

P/ 100 bo 4 bw 13 hr.

Comp. 109 bopd 4% wtr.