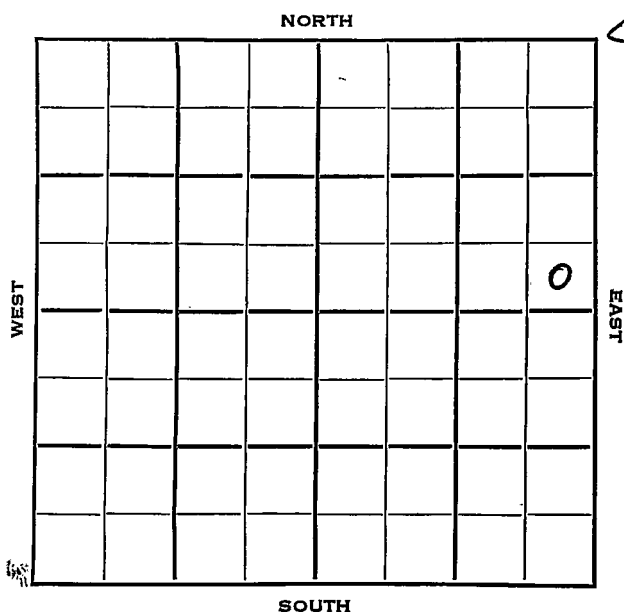


Section 27 Township 11 Range 19 WWell No. #2 ~~#1~~ C. E. Vine "B"Company Skelly Oil & Continental Oil

County Ellis State KansasSec. 27 (Blk.
Twp.) 11 (Sur.
Rge.) 19W Map No.Operator Skelly Oil & Continental OilWell No. 1 Farm C. E. VineElev. _____ Location SE SE NE

FIRST REPORT

330 Ft. From S Line NE330 Ft. From E Line Quarter1st. Report MAY 27 1953

Completion _____

Remarks _____

Spudding Date _____

Drlg. Data _____

Solomon PoolLocation

Kansas

Map No. _____ Sec. 27 Twp. 11 R. 19W

Well No. 2 C. E. Vine "B"

Skelly Oil & Cont'l

Company

CORRECTION

Contractor

SE SE NE

SECTION PLAT

			6

_____ Ft. from N. Line

330 Ft. from S. Line

330 Ft. from E. Line

_____ Ft. from W. Line

Ellis County

Location _____

Rig up _____

Drilling and Remarks:

Reported

1 Vine

RECORD

Cased _____ in., _____ ft.

Sand _____

Gas _____

Oil _____

Total Depth _____

PRODUCTION

1st 24 hrs. Nat. _____

1st 24 hrs. after shot _____

Gas _____ Cu. Ft.

Dry Hole _____


Abandoned _____

Date

JUN 3 1953 19

J. G. McGEHEE

Scout

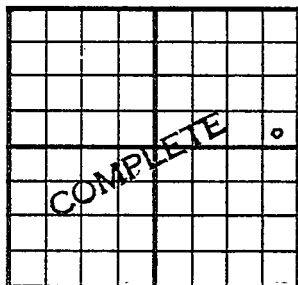County Ellis State KansasSec. 27 (Blk.) 11 (Sur.) 19W Map No.Operator Skelly Oil & Continental OilWell No. 2 Farm C. E. Vine "B"Elev. 2095 Location SE SE NE330 Ft. From S Line NE330 Ft. From E Line Quarter

1st. Report

Completion JUL 1 1953Remarks Solomon PoolSpudding Date 5-28-53Drlg. Data Oil well TD 3618Anhy 1380 8" @ 1395 Heeb. 3277Tor. 3295 Lans. 3318 Cong. 3580Simp. 3600 Arb. 3610 TD 3614FU 225' oil 3 hr. DD 3616 FU 500' oil4 hr. DD 3618 FU 1300' oil 6 hr.500 A P/ 234 bo 12 hr. Comp. 432 bopd

J. G. McGEHEE