


Section 27 Township 11 Range 19W

Well No. #2 Vine "A"

Company Skelly
Sullivan

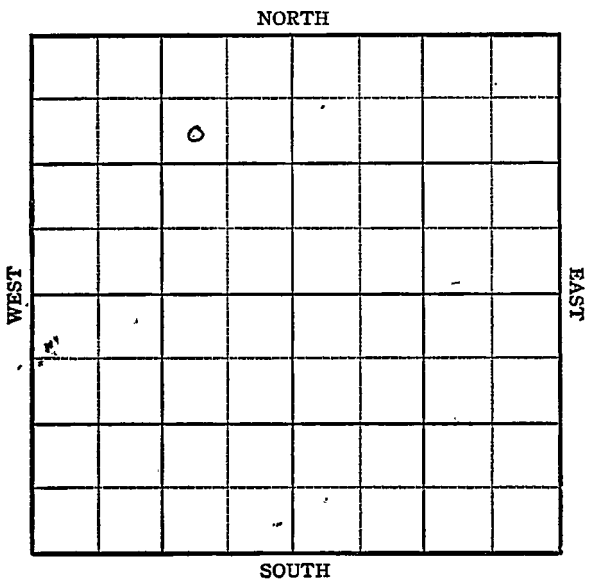

3

Sec. 27 Twp. 11 R. 19-W ✓

Well No. #2 Vine "A" Farm

Skelly Company

Sullivan


990 Ft. from N. Line

Ft. from S. Line

990 Ft. from E. Line

Ft. from W. Line

SW NE NW

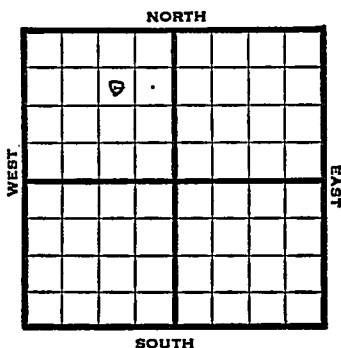

1948	Elev. 2115' REPORT
10/13	Location
10/19	"
10/26	1348 Run 8"
11/3	8" @ 1405' Drlg. 2718'
11/10	Lansing 3314' Arbuckle 3623' TD 3630' Run 5"
11/16	5" @ 3624'
11/23	38 shots 3090-3106' no shows.
11/30	TD 3632 2600' oil 20 hrs. Pump 158 bbls oil 15 hrs.
12/8	"
12/15	"
12/22	"
12/29	"
1949	
1/5	Arbuckle 3623' 5" @ 3624' Pump 333 oil Pot. Gr. 29° TD 3634'
	COMPLETED

Map No. _____ Sec. 27 Twp. 11 R. 19W

Well No. 2 Vine "A"

Skelly Company

FIRST REPORT Contractor

SW NE NW

SECTION PLAT

990 Ft. from N. Line

_____ Ft. from S. Line

990 Ft. from E. Line

_____ Ft. from W. Line

Ellis County

RECORD

Location x

Cased _____ in. _____ ft.

Rig up _____

Sand _____

Drilling and Remarks:

Gas _____

Oil _____

Total Depth _____

PRODUCTION

1st 24 hrs. Nat. _____

1st 24 hrs. after shot _____

Gas _____ Cu. Ft.

Dry Hole _____

Abandoned _____

Date

OCT 13 1948 19

S. J. LEWIS Scout

