


Section 27 Township 11 Range 19W

Well No. #5 Vine (A)

Company Skelly Oil

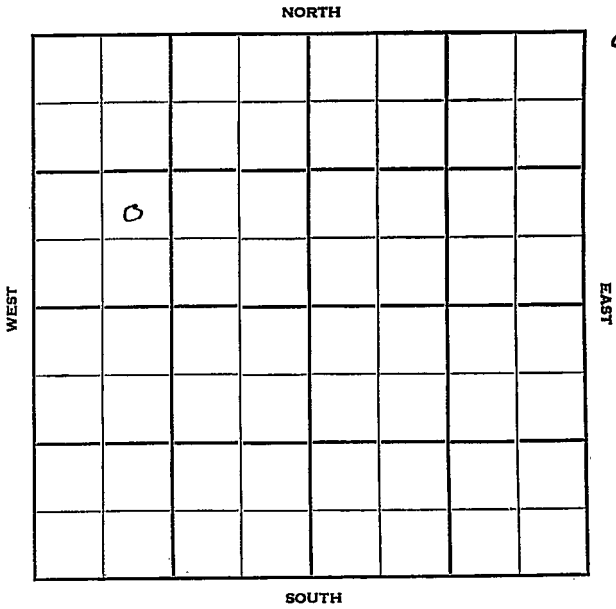

Sec. 27 Twp. 11 R. 19W

Well No. #5 Vine (A) Farm _____

Skelly Oil Company _____

Soloman Contractor _____


_____ Ft. from N. Line

990' Ft. from S. Line

_____ Ft. from E. Line

990' Ft. from W. Line

NE SW NW

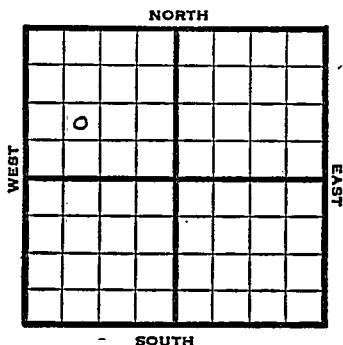

1951

Elev. 2084' REPORT

9/12

Location

10/3

Spud 9-12-51 D & A TD 3617'
 8" @ 320' Top. 3071' Heeb 3272'
 Lans. 3314' Cong. 3564' Simp 3593'
 Arb. 3615'
 TD 3617'
 DST 3615-19' open 1 hr. rec 10' mud
 DST 3618-30' open 1/2 hr. rec 25' mud
 D & A

ABANDONED

