

Section 27 Township 11 Range 19-WWell No. 1 Vine "B"Company Skelly & Continental

Solomon Pool

NORTH

				0			

WEST

EAST

SOUTH

KANSAS

Ellis County

Sec. 27 Twp. 11 R. 19- W

Well No. 1 Vine "B" Farm

Skelly & Continental Company

Solomon Pool


330 Ft. from N. Line

Ft. from S. Line

Ft. from E. Line

330 Ft. from W. Line

NW NE

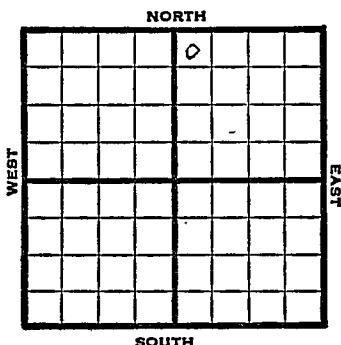

1947

EL. 2108'

REPORT

7-16

RUR

7/22

13" @ 158'
Ankydrite 1399'
8" @ 1409'
WOC

7/29

Topeka 3085'
Drig. 3197'

8/6

Lans. 3325'
Cong. 3601'
3752' in Cong.
T.D. 3752'
Aban doned

ABANDONED

Map No. _____ Sec. 27 Twp. 11 R. 19W

Well No. 1 Vine "B"

Skelly & Continental Company

FIRST REPORT

Contractor

NWNE


SECTION PLAT

330 Ft. from N. Line

_____ Ft. from S. Line

_____ Ft. from E. Line

330 Ft. from W. Line

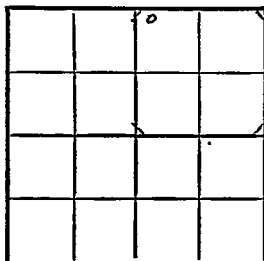

Ellis County

Location _____

Rig up _____

Drilling and Remarks:

R U R

RECORD

Cased _____ in, _____ ft.

Sand _____

Gas _____

Oil _____

Total Depth _____

PRODUCTION

1st 24 hrs. Nat. _____

1st 24 hrs. after shot _____

Gas _____ Cu. Ft.

Dry Hole _____

Abandoned _____

Date

JUL 16 1947 19

S. J. LEWIS Scout

Map No. 70 Sec. 27 Twp. 11 R. 19W

Well No. 1 Vine "B"

Skelly & Continental Company

ABANDONED Contractor

NW NE

E 12108
SECTION PLAT

330 Ft. from N. Line

 Ft. from S. Line

 Ft. from E. Line

330 Ft. from W. Line

		0	

Ellis County

Location

Rig up

Drilling and Remarks:

Ham 335
Cong 3601
3752 in Cong

RECORD

Cased in., ft.

Sand

Gas

Oil

Total Depth 3752

PRODUCTION

1st 24 hrs. Nat.

1st 24 hrs. after shot

Gas Cu. Ft.

Dry Hole

Abandoned

Date

AUG 6 1947 19

S. J. LEWIS

Scout