


Section 27 Township 11 Range 17-~~W~~

Well No. #23 Bauming (Baumer)

Company Deep Rock

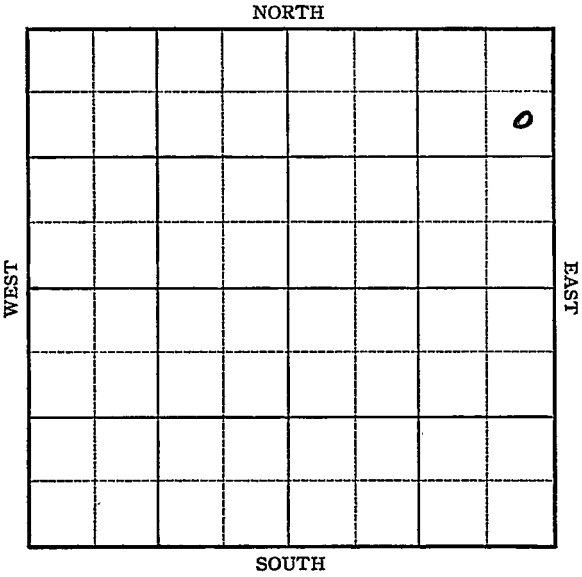

Ellis

KANSAS

Map No. _____ Sec. 27 Twp. 11 R. 1725Well No. 23 Banning
Deep Rock Company

Contractor _____

FIRST REPORT

SECTION PLAT

			0

990 Ft. from N. Line

_____ Ft. from S. Line

330 Ft. from E. Line

_____ Ft. from W. Line

Location _____

Rig up _____

Drilling and Remarks:

Cellar

RECORD

Cased _____ in., _____ ft.

Sand _____

Gas _____

Oil _____

Total Depth _____

PRODUCTION

1st 24 hrs. Nat. _____

1st 24 hrs. after shot _____

Gas _____ Cu. Ft.

Dry Hole _____

Abandoned _____

Date

SEP 22 1937

19

H. D. Hatfield

Scout

KANSAS

Ellis

Map No. _____ Sec. 27 Twp. 11 R. 17WWell No. 23 Baumer

Deep Rock Oil _____ Company

Contractor _____

COMPLETED

SE NE NE

990 Ft. from N. Line

_____ Ft. from S. Line

330 Ft. from E. Line

_____ Ft. from W. Line

SECTION PLAT

			0

Location _____

Rig up _____

Drilling and Remarks:

Pot-3233

NAT.

RECORD

Cased 7 in. 3383 ft.Sand 511 3382

Gas _____

Oil _____

Total Depth 3396

PRODUCTION

1st 24 hrs. Nat. _____

1st 24 hrs. after shot _____

Gas _____ Cu. Ft.

Dry Hole _____

Abandoned _____

Date

OCT 27 1937₁₉

H. D. Hatfield

Scout