

KANSAS

FORM 51 5M 1-42 PETROL


Ellis

Section 27 Township 11 Range 17-W

Well No. 38 Baumer

Company Deep Rock

NORTH Bemis Pool

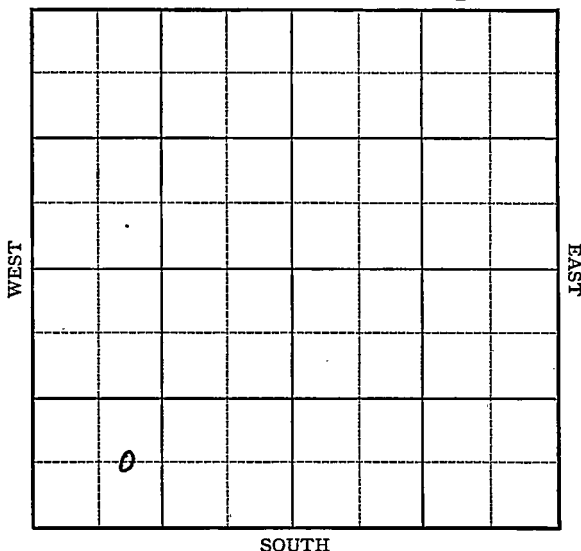

13

Sec. 27 Twp. 11 R. 17-W

Well No. #38 Baumer Farm

Deep Rock Company

(Bemis)


 Ft. from N. Line

660 Ft. from S. Line

 Ft. from E. Line

990 Ft. from W. Line

Elev. 2106

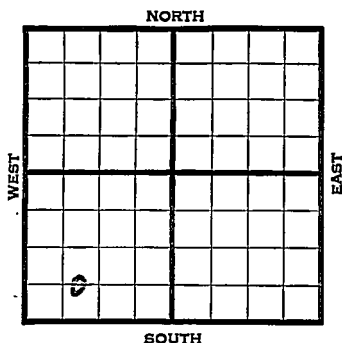

	REPORT
1942	
2/25	13" - 45'
	1345' Run pipe.
3/5	8" - 1349' Drlg. 2960'
3/12	Arb. 3633' T.D. 3637' Run 5".
3/19	5" - 3633' T.D. 3637' 1000 acid.
	C.O.
3/26	"
4/2	"
4/8	"
4/15	"
4/22	"
4/29	"
5/6	Arb. 3633'
	5" - 3633'
	T.D. 3627'
	1000 acid.
	Potential 100 bbls., pump.
	34.6 Gravity
	COMPLETED

Map No. 21 Sec. 27 Twp. 11 R. 17WWell No. 38 BaumerDeep Rock

Company

FIRST REPORT

Contractor

C EL SW SW

SECTION PLAT

o			

Ft. from N. Line

660

Ft. from S. Line

Ft. from E. Line

990

Ft. from W. Line

BEMIS POOL

Location

Rig up

Drilling and Remarks:

13" - 45'

1345' Run Pipe

RECORD

Cased _____ in., _____ ft.

Sand _____

Gas _____

Oil _____

Total Depth _____

PRODUCTION

1st 24 hrs. Nat. _____

1st 24 hrs. after shot _____

Gas _____ Cu. Ft.

Dry Hole _____

Abandoned _____

Date

FEB 25 1942

19

S. J. LEWIS Scout

Map No. 71 Sec. 27 Twp. 11 R. 17WWell No. 38 BaumerDeep Rock CompanyCOMPLETED Contractor

C EL SW SW

SECTION PLAT

0			

 Ft. from N. Line660 Ft. from S. Line Ft. from E. Line990 Ft. from W. Line

BEMIS POOL

Location Rig up

Drilling and Remarks:

Per 43633
5" @ 3633
1000 acid
Pump 100 Bx

346 gr

RECORD

Cased in., ft.Sand Gas Oil Total Depth 3627

PRODUCTION

1st 24 hrs. Nat. 1st 24 hrs. after shot Gas Cu. Ft.Dry Hole Abandoned

Date

MAY 6 1942 19 S. J. LEWIS Scout