


Ellis

Section 27 Township 11 Range 17-W

Well No. #36 Baumer

Company Deep Rock

(Bemis)

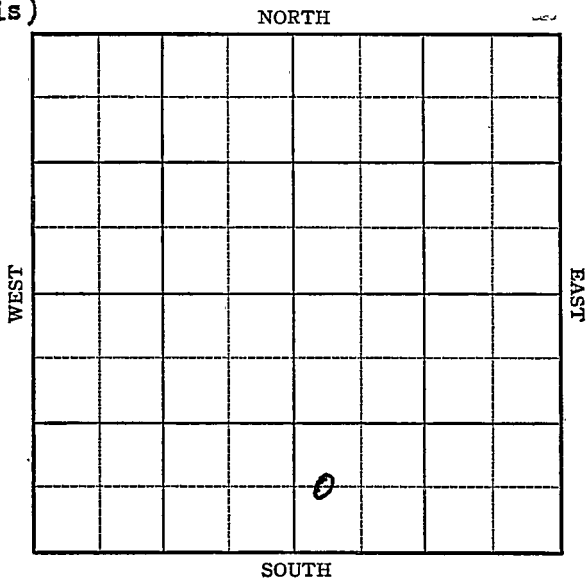

KANSAS

Ellis

Sec. 27 Twp. 11 R. 17-W

Well No. #36 Baumer Farm

Deep Rock Company

(Bemis)

 Ft. from N. Line


660

~~530~~ Ft. from S. Line

 Ft. from E. Line

330

~~660~~ Ft. from W. Line

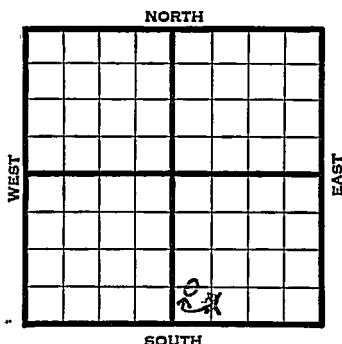

Elev. 2104

1941	REPORT
12/3	13" - 35'
	Drlg. 502'
12/11	Anhy 1306 8" @ 1318 Drlg. 1950
12/18	Topeka 3005 Drlg. 3440
12/24	Arb. 3576' 5" - 3576' T.D. 3588'
	2800' oil 11½ hours.
12/31	1000 acid.
1942	
1/7	Arb. 3576'
	5" - 3576'
	T.D. 3593'
	3000 acid.
	Echometer potential 2450 bbls.
	34.6 Gravity
	COMPLETED

Map No. 71 Sec. 27 Twp. 11S R. 17WWell No. 36 BaumerDeep Rock CompanyCOMPLETED Contractor

C WL SW SE

 Ft. from N. Line660 Ft. from S. Line Ft. from E. Line330 Ft. from W. Line

SECTION PLAT

		0	

BEMIS POOL

Location Rig up

Drilling and Remarks:

Cor 35765" C 35768000 DepthEcho 2450246/42

RECORD

Cased in., ft.Sand Gas Oil Total Depth 952.9

PRODUCTION

1st 24 hrs. Nat. 1st 24 hrs. after shot Gas Cu. Ft.Dry Hole Abandoned

Date

JAN 7 1942

19

S. J. LEWIS Scout

Ellis **KANSAS**Map No. 71 Sec. 27 Twp. 11 R. 17WWell No. 36 BaumerDeep Rock CompanyCORRECTION Contractor

C WL SW SE

 Ft. from N. Line660 Ft. from S. Line Ft. from E. Line330 Ft. from W. Line

SECTION PLAT

BEMIS POOL

Location Rig up

Drilling and Remarks:

Reported

C SL SW SE

RECORD

Cased in., ft.Sand Gas Oil Total Depth

PRODUCTION

1st 24 hrs. Nat. 1st 24 hrs. after shot Gas Cu. Ft.Dry Hole Abandoned

Date

DEC 10 1941

19

S. J. LEWIS

Scout

Ellis

KANSAS

Map No. 7/ Sec. 27 Twp. 11S R. 17WWell No. 36 BaumerDeep Rock

Company

FIRST REPORT

Contractor

C S $\frac{1}{2}$ SW SE Ft. from N. Line330 Ft. from S. Line Ft. from E. Line660 Ft. from W. Line

SECTION PLAT

BEMIS POOL

Location Rig up

Drilling and Remarks:

13" - 35'Drlg. 502'

RECORD

Cased in., ft.Sand Gas Oil Total Depth

PRODUCTION

1st 24 hrs. Nat. 1st 24 hrs. after shot Gas Cu. Ft.Dry Hole Abandoned

Date

DEC 3 1941 19S. J. LEWIS Scout