


Section 27 Township 11 Range 17-W

Well No. #34 Baumer

Company Deep Rock

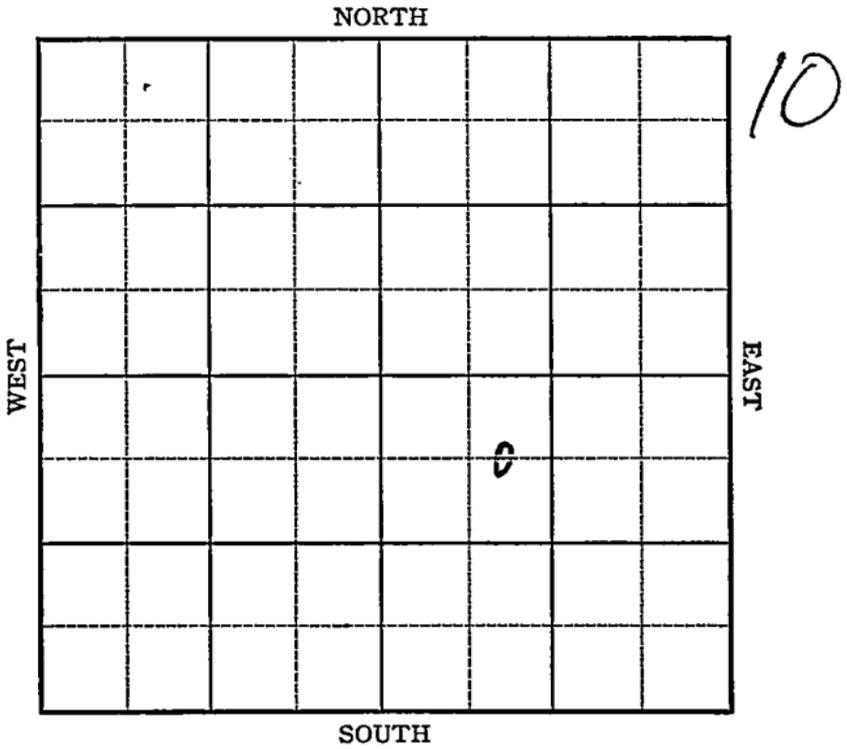

Sec. 27 Twp. 11 R. 17-W

Well No. #34 Baumer Farm

Deep Rock Company

(Bemis)


660 Ft. from N. Line

_____ Ft. from S. Line

_____ Ft. from E. Line

990 Ft. from W. Line

Elev. 2080

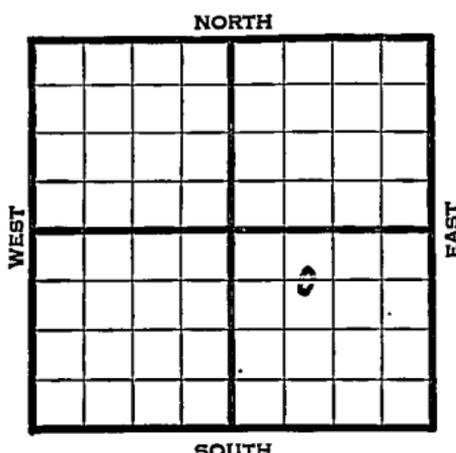

REPORT	
1941	
10/22	1342' run 10".
10/30	8" - 1326' Drlg. 250.8'
11/6	Simp. 3554' Arb. 3564-67' T.D. Run casing.
11/13	4" - 3565' T.D. 3574' 1400' oil.
11/20	1000 acid. Pump 15 oil per hr. Drlg. 3579'
11/26	T.D. 3579' 4000 acid. Echometer test 813 bbls.
12/3	Arb. 3564' 4" - 3565' T.D. 3586' 10,000 acid. Echometer potential 1675 bbls. 34.6 Gravity
COMPLETED	

Ellis

Map No. K-71 Sec. 27 Twp. 11 R. 17WWell No. 34 BaumerDeep Rock Company**FIRST REPORT**

Contractor

C EL NW SE

SECTION PLAT

660 Ft. from N. Line

_____ Ft. from S. Line

_____ Ft. from E. Line

990 Ft. from W. Line

BEMIS POOL

Location _____

Rig up _____

Drilling and Remarks:

1342 Run 10'

RECORD

Cased _____ in., _____ ft.

Sand _____

Gas _____

Oil _____

Total Depth _____

• PRODUCTION

1st 24 hrs. Nat. _____

1st 24 hrs. after shot _____

Gas _____ Cu. Ft.

Dry Hole _____

Abandoned _____

Date

OCT 22 1941 19S. J. LEWIS Scout

E l l i s

KANSAS

Map No. 71 Sec. 27 Twp. 011 R. 17WWell No. 34 BaumerDeep Rock

Company

COMPLETED

Contractor

C E L N W S E

SECTION PLAT

660 Ft. from N. Line

_____ Ft. from S. Line

_____ Ft. from E. Line

990 Ft. from W. Line

BEMIS POOL

Location _____

Rig up _____

Drilling and Remarks:

*Cor & 3564.**4" @ 3565.**10000 acid**Echo Pat 1675**34592*

RECORD

Cased _____ in., _____ ft.

Sand _____

Gas _____

Oil _____

Total Depth 3588

PRODUCTION

1st 24 hrs. Nat. _____

1st 24 hrs. after shot _____

Gas _____ Cu. Ft.

Dry Hole _____

Abandoned _____

Date

DEC 3 1941 19

S. J. LEWIS Scout