


Section 27 Township 11 Range 17-W

Well No. 32 Baumer

Company Deep Rock Oil

NORTH Bemis Pool

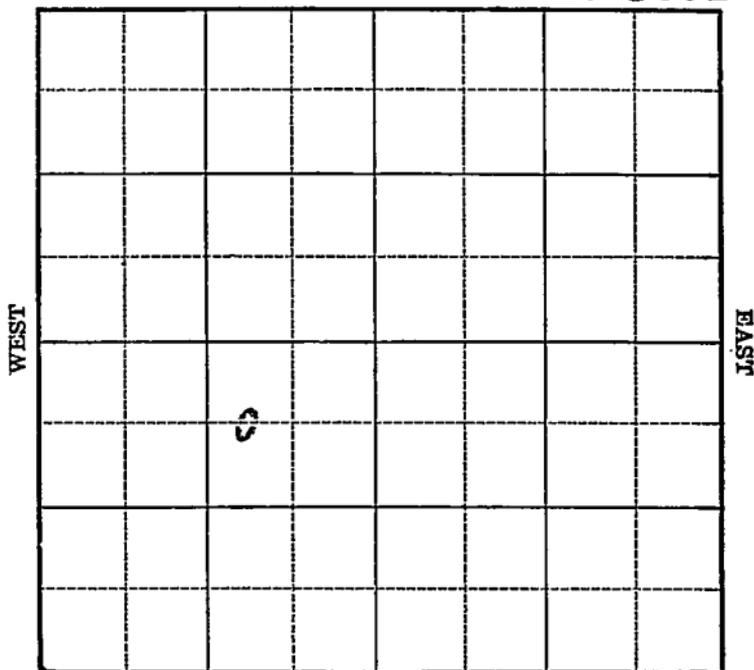

SOUTH

Sec. 27 Twp. 1E R. 17-W

Well No. #32 Baumer Farm

Deep Rock Oil

Company

(Bemis)


660 Ft. from N. Line

_____ Ft. from S. Line

990 Ft. from E. Line

_____ Ft. from W. Line

Elev. 2086

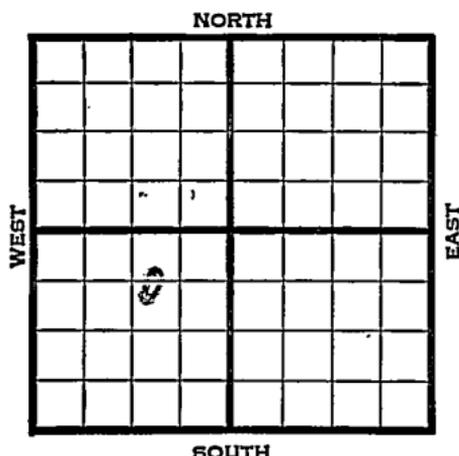

1941	REPORT
1/8	Location
1/16	R.O.G.
1/23	Derrick.
1/30	13" - 40'
	Drlg. 800'
2/6	Anhy 1270' 8" - 1308'
	Drlg. 2500'
2/13	Arb. 3561-65' T.D.
	5" - 3562' RUST.
2/20	" " "
2/26	Arb. 3561'
	5" - 3562'
	T.D. 3565'
	Echometer potential 9353 bbls.
	Maximum 3000 bbls.
	33.5 Gravity
	COMPLETED

Map No. 71 Sec. 27 Twp. 11 R. 17WWell No. 32 BaumerDeep Rock Oil

Company

Contractor

FIRST REPORT

C W L NE SW

SECTION PLAT660 Ft. from N. Line

_____ Ft. from S. Line

990 Ft. from E. Line

_____ Ft. from W. Line

BEMIS POOL

	o		

Location X

Rig up _____

Drilling and Remarks:

RECORD

Cased _____ in., _____ ft.

Sand _____

Gas _____

Oil _____

Total Depth _____

PRODUCTION

1st 24 hrs. Nat. _____

1st 24 hrs. after shot _____

Gas _____ Cu. Ft.

Dry Hole _____

Abandoned _____

Date

JAN 8 1941 19S. J. LEWIS Scout

Map No. 71 Sec. 27 Twp. 11 R. 17W

Well No. 32 Baumer

Deep Rock Oil Company

Contractor

COMPLETED

C W L N E S W

660 Ft. from N. Line

_____ Ft. from S. Line

990 Ft. from E. Line

_____ Ft. from W. Line

SECTION PLAT

	o		

BEMIS POOL

Location _____

Rig up _____

Drilling and Remarks:

Cur 3561
5" @ 3562
Echo Prod. 9353
May 3000

33.5 Gr.

RECORD

Cased _____ in., _____ ft.

Sand _____

Gas _____

Oil _____

Total Depth 3565

PRODUCTION

1st 24 hrs. Nat. _____

1st 24 hrs. after shot _____

Gas _____ Cu. Ft.

Dry Hole _____

Abandoned _____

Date

FEB 26 1941₁₉

S. J. LEWIS Scout