

KANSAS


FORM 51 5M 2-38 TPCO.


Ellis

Section 27 Township 11 Range 17-W

Well No. 28 Baumer

Company Deep Rock

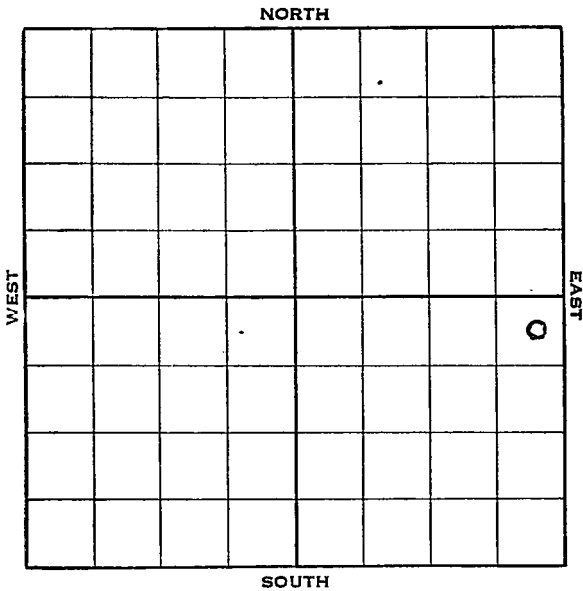

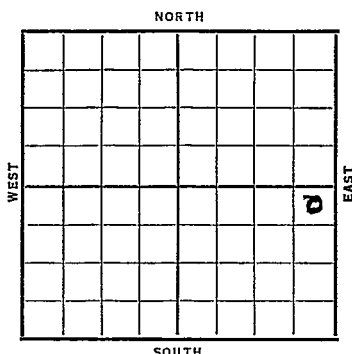Sec. 27 Twp. 11 R. 17-WWell No. #28 Baumer FarmDeep Rock Company330 Ft. from N. Line Ft. from S. Line330 Ft. from E. Line Ft. from W. Line

Elev. 1936'.

Date

REPORT

1938

2/9

S. H.

2/18

15" @ 79'. Anhy 1143'.

10" @ 1146'. Drlg. 12010'.

2/26

Drlg. 3250'.

3/4

Arb. 3393'. 7" @ 3394'.

Drlg. 3402'. 2700' oil.

3/9

7" @ 3394'.

Arb. 3393'.

T.D. 3409'.

Potential 3339 bbls., Nat.

COMPLETED

Ellis **KANSAS**Map No. _____ Sec. **27** Twp. **11** R. **17W**Well No. **28** **Baumer**_____ **Deep Rock** _____ Company

_____ Contractor

FIRST REPORT**SECTION PLAT****NE SE****330** Ft. from N. Line

_____ Ft. from S. Line

330 Ft. from E. Line

_____ Ft. from W. Line

			0

Location _____

Rig up _____

Drilling and Remarks:

SH**RECORD**

Cased _____ in., _____ ft.

Sand _____

Gas _____

Oil _____

Total Depth _____

PRODUCTION

1st 24 hrs. Nat. _____

1st 24 hrs. after shot _____

Gas _____ Cu. Ft.

Dry Hole _____

Abandoned _____

Date

FEB 9 1938₁₉**H. D. Hatfield** Scout

Ellis

KANSAS

Map No. _____ Sec. 27 Twp. 11 R. 17WWell No. 28 BaumerDeep Rock Company

Contractor _____

COMPLETED

SECTION PLAT

NE SE

330 Ft. from N. Line

_____ Ft. from S. Line

330 Ft. from E. Line

_____ Ft. from W. Line

			0

Location _____

Rig up _____

Drilling and Remarks:

RECORD

Cased 7 in., 3394 ft.Sand Arb 3393

Gas _____

Oil _____

Total Depth 3409

PRODUCTION

1st 24 hrs. Nat. _____

1st 24 hrs. after shot _____

Gas _____ Cu. Ft.

Dry Hole _____

Abandoned _____

Pot 3339

NOT

Date

MAR 9 - 1938₁₉

H. D. Hatfield

Scout