
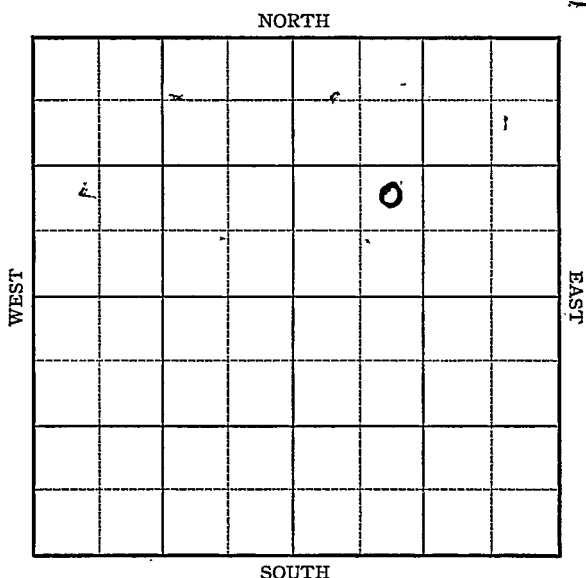


Ellis

Section 27 Township 11 Range 17-WWell No. 24 BaumerCompany Deep Rock

Sec. 27 Twp. 11 R. 17-WWell No. #24 Baumer Farm
Deep Rock Company Ft. from N. Line990 Ft. from S. Line Ft. from E. Line990 Ft. from W. Line

Elev. 2002

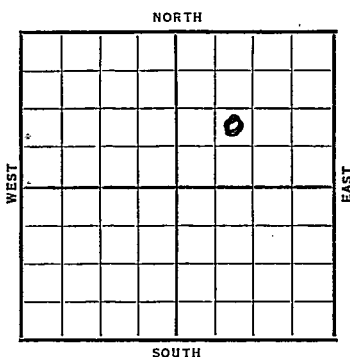

Date

REPORT

1937

10/6

Location

10/15

15" @ 28'. Anhy 1219'.

10" @ 1224'. WOC.

10/22

Drlg. 2964'.

10/29

Coring 3533'.

11/5

Sil. 3726'. Drlg. 3805'.

No shows.

11/12

Granite wash 3995'.

T.D. 4002'. P.B. 3521'.

Rng. 7".

11/19

7" @ 3521'.

11/26

S.D.O.

12/3

"

12/10

"

OVER

1937

12/15 7" @ 3521'.

Sil. 3726'.

Granite wash 3995'.

T.D. 4002'.

P.B. 3521'.

ABANDONED

Ellis

KANSAS

Map No. _____ Sec. 27 Twp. 11 R. 17WWell No. 24 BaumerDeep Rock

Company _____

Contractor _____

NE SW NE

FIRST REPORT

SECTION PLAT

		0	

_____ Ft. from N. Line

990 Ft. from S. Line

_____ Ft. from E. Line

990 Ft. from W. LineLocation X

Rig up _____

Drilling and Remarks:

RECORD

Cased _____ in., _____ ft.

Sand _____

Gas _____

Oil _____

Total Depth _____

PRODUCTION

1st 24 hrs. Nat. _____

1st 24 hrs. after shot _____

Gas _____ Cu. Ft.

Dry Hole _____

Abandoned _____

Date

OCT - 6 1937

19

H. D. Hatfield

Scout



 RAN

Returned	
Cards	<i>[Signature]</i>
Time to	<i>[Signature]</i>

Ellis KANSAS

Map No. 71 Sec. 27 Twp. 11 R. 17WWell No. 24 BaumerDeep Rock

Company

Contractor

ABANDONED

NE SW NE

 Ft. from N. Line990 Ft. from S. Line Ft. from E. Line990 Ft. from W. Line

SECTION PLAT

		0	

Location Rig up

Drilling and Remarks:

P.B. 3521DVA

RECORD

Cased 7 in., 352 ft.Sand 511 3726~~Gas~~ Granite wash 3995Oil Total Depth 4002

PRODUCTION

1st 24 hrs. Nat. 1st 24 hrs. after shot Gas Cu. Ft.Dry Hole Abandoned

Date

DEC 15 193719H. D. HatfieldScout




Red

Returned

Cards

HS

State

Moody Plan

Paul
Jim
Red