

Ellis


Form 51-5M 5-37 Petrol

KANSAS

Section 27 Township 11 Range 17-W

Well No. 20 Baumer

Company Deep Rock

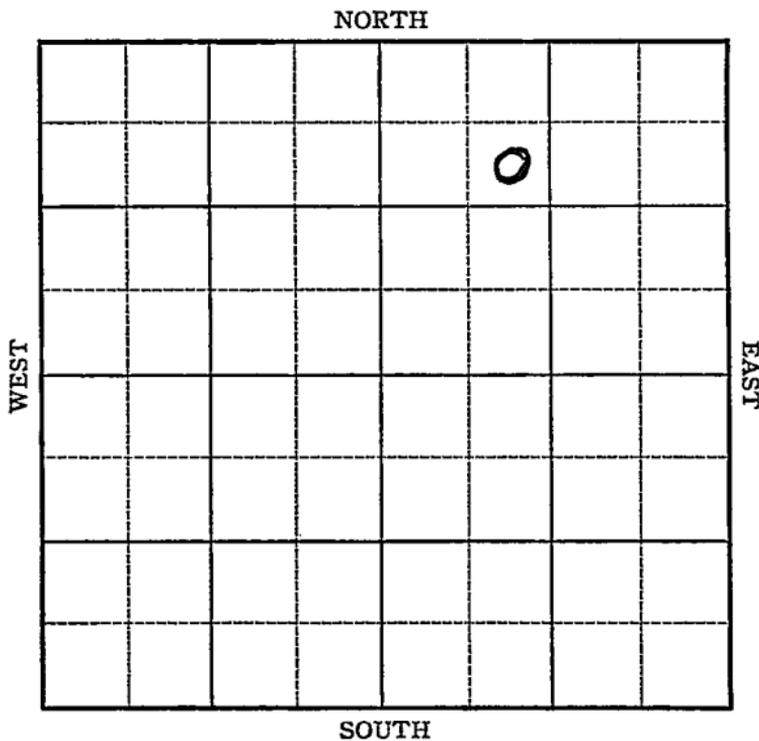

Sec. 27 Twp. 11 R. 17-W


Well No. #20 Baumer Farm  
Deep Rock Company

990 Ft. from N. Line

\_\_\_\_\_ Ft. from S. Line

\_\_\_\_\_ Ft. from E. Line

990 Ft. from W. Line

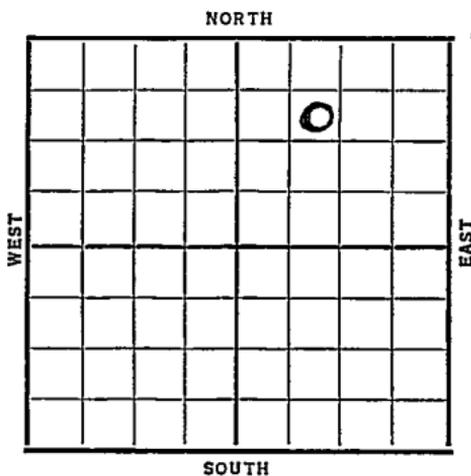

Date	REPORT
1937	
9/15	15" - 80'
	Anhy 1250'
	10" - 1261' WOC
9/24	Drlg. 2625'.
10/2	Drlg. 3427'.
10/8	Sil. 3516', 7" @ 3517'.
	T.D. 3530'. 3000' oil.
10/13	7" @ 3517'.
	Sil. 3516'.
	T.D. 3530'.
	Potential 3430 bbls. Nat.
	<b>COMPLETED</b>

*Ellis*

KANSAS

Map No. \_\_\_\_\_ Sec. 27 Twp. 11 R. 17<sup>w</sup>

Well No. 20-Baumer

Deep Rock Company

FIRST REPORT Contractor

**SECTION PLAT**

990 Ft. from N. Line  
 \_\_\_\_\_ Ft. from S. Line  
 \_\_\_\_\_ Ft. from E. Line  
990 Ft. from W. Line

		0	

Location \_\_\_\_\_

Rig up \_\_\_\_\_

Drilling and Remarks:

*15" 80*  
*ANhy-1250*  
*10" 1261 WOC*

**RECORD**

Cased \_\_\_\_\_ in., \_\_\_\_\_ ft.  
 Sand \_\_\_\_\_  
 Gas \_\_\_\_\_  
 Oil \_\_\_\_\_  
 Total Depth \_\_\_\_\_

**PRODUCTION**

1st 24 hrs. Nat. \_\_\_\_\_  
 1st 24 hrs. after shot \_\_\_\_\_  
 Gas \_\_\_\_\_ Cu. Ft.  
 Dry Hole \_\_\_\_\_  
 Abandoned \_\_\_\_\_

Date

SEP 15 1937

19

H. D. Hatfield

Scout

Map No. \_\_\_\_\_ Sec. 27 Twp. 11 R. 17W

Well No. 20 Baumer

Deep Rock Company

Contractor

COMPLETED

SECTION PLAT

SE NW NE

990 Ft. from N. Line

\_\_\_\_\_ Ft. from S. Line

\_\_\_\_\_ Ft. from E. Line

990 Ft. from W. Line

		0	

Location \_\_\_\_\_

Rig up \_\_\_\_\_

Drilling and Remarks:

POT-3430  
NAT

RECORD

Cased 7 in., 3517 ft.

Sand 511 3516

Gas \_\_\_\_\_

Oil \_\_\_\_\_

Total Depth 3530

PRODUCTION

1st 24 hrs. Nat. \_\_\_\_\_

1st 24 hrs. after shot \_\_\_\_\_

Gas \_\_\_\_\_ Cu. Ft.

Dry Hole \_\_\_\_\_

Abandoned \_\_\_\_\_

Date

OCT 13 1937 19

H. D. Hatfield

S