


Company Deep Rock

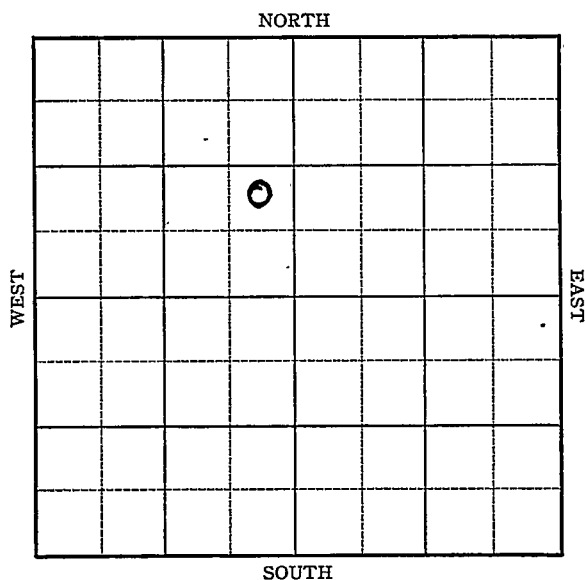

KANSAS

Map No. _____ Sec. 27 Twp. 11 R. 17^WWell No. 19 - BaumerDeep Rock Company

Contractor _____

FIRST REPORT

SECTION PLAT

	0		

_____ Ft. from N. Line

990 Ft. from S. Line330 Ft. from E. Line

_____ Ft. from W. Line

Location _____

Rig up _____

Drilling and Remarks:

B.R.R.

RECORD

Cased _____ in., _____ ft.

Sand _____

Gas _____

Oil _____

Total Depth _____

PRODUCTION

1st 24 hrs. Nat. _____

1st 24 hrs. after shot _____

Gas _____ Cu. Ft.

Dry Hole _____

Abandoned _____

Date

AUG 11 1937H. D. Hatfield Scout

KANSAS

Map No. _____ Sec. 27 Twp. 11 R. 17W

Well No. 19 - Baumer

Deep Rock Company

Contractor

SECTION PLAT

_____ Ft. from N. Line

990 Ft. from S. Line

330 Ft. from E. Line

_____ Ft. from W. Line

COMPLETED

Location _____

Rig up _____

Drilling and Remarks:

Pump
3370 bbls
Natural

RECORD

Cased _____ in., _____ ft.

Sand 3528

Gas _____

Oil _____

Total Depth 3542

PRODUCTION

1st 24 hrs. Nat. _____

1st 24 hrs. after shot _____

Gas _____ Cu. Ft.

Dry Hole _____

Abandoned _____

Date

SEP 22 1937

19

H. D. Hatfield

Scout