


Ellis

KANSAS

Section 27 Township 11 Range 17-W

Well No. 9 - Baumer

Company Deep Rock

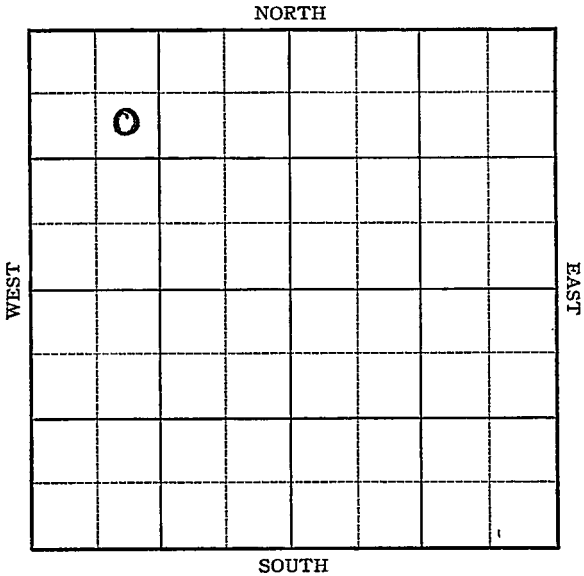

KANSAS

Map No. _____ Sec. 27 Twp. 11 R. 17 ^WWell No. 9 - BaumerDeep Rock Company

Contractor _____

FIRST REPORT

SECTION PLAT

0			

990 Ft. from N. Line60 Ft. from S. Line Ft. from E. Line990 Ft. from W. LineLocation ✓

Rig up _____

Drilling and Remarks: _____

RECORD

Cased _____ in., _____ ft.

Sand _____

Gas _____

Oil _____

Total Depth _____

PRODUCTION

1st 24 hrs. Nat. _____

1st 24 hrs. after shot _____

Gas _____ Cu. Ft.

Dry Hole _____

Abandoned _____

Date

JUN 2 1937 19 H. D. Hatfield Scout

KANSAS

Map No. _____ Sec. 27 Twp. 11 R. 17^WWell No. 9. BaumerDeep Rock Company

Contractor _____

SECTION PLAT

0			

COMPLETED

990 Ft. from N. Line

_____ Ft. from S. Line

_____ Ft. from E. Line

990 Ft. from W. Line

Location _____

Rig up _____

Drilling and Remarks:

758/6 hrsRot - 2730

RECORD

Cased 7 in. 3455 ft.Sand 511 3454

Gas _____

Oil _____

Total Depth 3464

PRODUCTION

1st 24 hrs. Nat. _____

1st 24 hrs. after shot _____

Gas _____ Cu. Ft.

Dry Hole _____

Abandoned _____

Date

JUL 14 1937 19

H. D. Hatfield

Scout