


Section 27 Township 11 Range 17-W

Well Number 6 - Baumer

Company Deep Rock

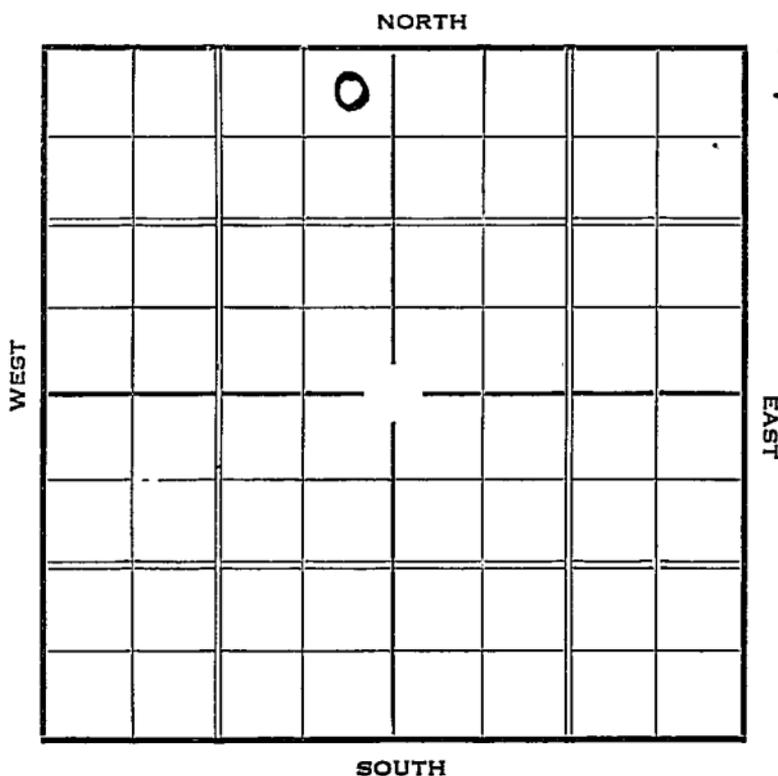

Sec. 28 Twp. 11 R. 17-W

Well No. #6 Baumer Farm
Deep Rock Company


330 Ft. from N. Line

_____ Ft. from S. Line

330 Ft. from E. Line

_____ Ft. from W. Line

Elev. 2024

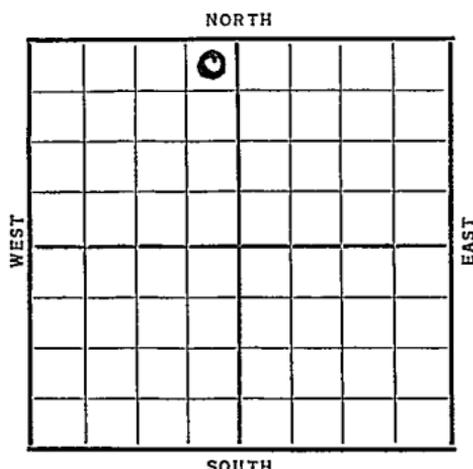

Date	REPORT
1937	
5/12	Rig Corners.
5/21	Rig
5/28	"
6/4	15" @ 61'. Anhy 1230'.
	Drlg. 1530'.
6/11	10" @ 1233'. Drlg. 2857'.
6/19	Drlg. 3388'.
6/25	Sil. 3484'. 7" @ 3484'.
	T.D. 3493'. 3000' oil 1½ hrs
6/30	7" @ 3477'.
	Sil. 3477'.
	T.D. 3491'.
	Pot. 2875 bbls. 24 hrs.
	Down 1½ hrs.
	COMPLETED

Ellis KANSAS

Map No. 71 Sec. 27 Twp. 11 R. 17^W

Well No. 6-Banner

Deep Rock Company

Contractor

FIRST REPORT

SECTION PLAT

	0		

530 Ft. from N. Line

_____ Ft. from S. Line

330 Ft. from E. Line

_____ Ft. from W. Line

Location _____

Rig up _____

Drilling and Remarks:

Rig Corner

RECORD

Cased _____ in., _____ ft.

Sand _____

Gas _____

Oil _____

Total Depth _____

PRODUCTION

1st 24 hrs. Nat. _____

1st 24 hrs. after shot _____

Gas _____ Cu. Ft.

Dry Hole _____

Abandoned _____

Date

MAY 12 1937 19

H. D. Hatfield Scout

Ellis

KANSAS

Map No. _____ Sec. 27 Twp. 11 R. 17 ^WWell No. 6-BaumerDeep Rock Company

Contractor

COMPLETED**SECTION PLAT**

		0		

330 Ft. from N. Line

_____ Ft. from S. Line

330 Ft. from E. Line

_____ Ft. from W. Line

Location _____

Rig up _____

Drilling and Remarks:

Pot 2875/24Down 1 1/2 hrs**RECORD**Cased 7 in., 3477 ft.Sand Si 1 3477

Gas _____

Oil _____

Total Depth 3491**PRODUCTION**

1st 24 hrs. Nat. _____

1st 24 hrs. after shot _____

Gas _____ Cu. Ft.

Dry Hole _____

Abandoned _____

Date

JUN 30 1937H. D. Hatfield

Scout