


Section 27 Township 11 Range 17<sup>1</sup>/<sub>2</sub>W

Well Number 1 Baumer

Company Deep Rock

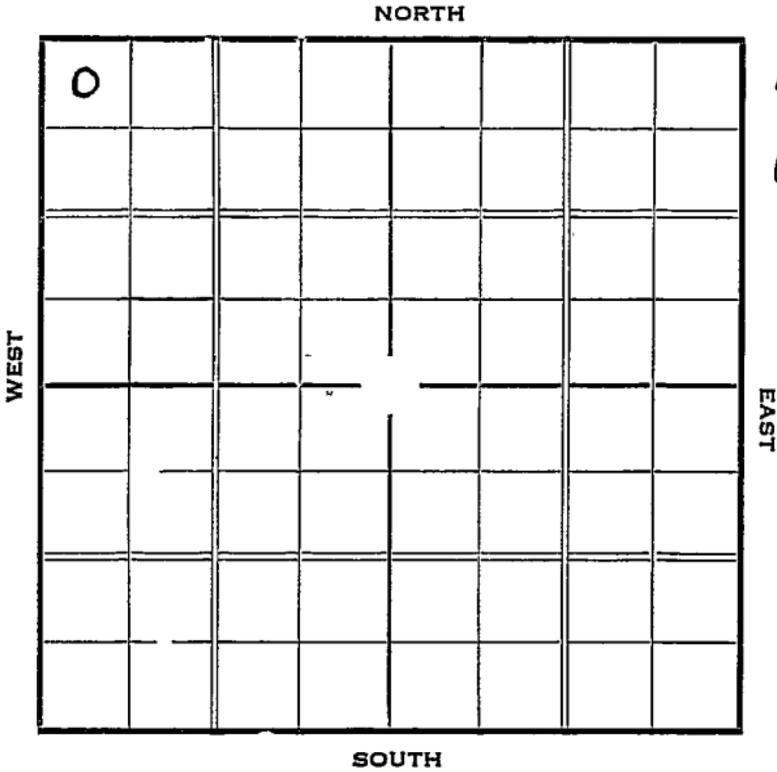

Sec. 27 Twp. 11 R. 17 W

Well No. #1 Baumer Farm  
Deep Rock Company


330 Ft. from N. Line

\_\_\_\_\_ Ft. from S. Line

\_\_\_\_\_ Ft. from E. Line

330 Ft. from W. Line

Elev. 1986

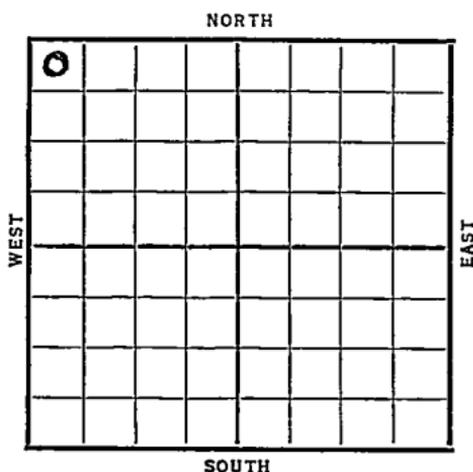

Date	REPORT
1937	
2/10	Location
2/19	" "
2/26	Rig.
3/4	15" @ 117' WOC.
3/11	10" @ 1195' WOC.
3/18	Drlg. 2060'.
3/25	Drlg. 2850'.
4/2	Drlg. 3320'
4/8	Sil 3443' 6" @ 3442' TD 3451-
	Hole full oil 8 hrs.
4/14	Sil. 3443'.
	T.D. 3451'.
	Potential 2620.
	<b>COMPLETED</b>

Map No. \_\_\_\_\_ Sec. 27 Twp. 11 R. 17W

Well No. 1 Banner

Deep Rock. Company \_\_\_\_\_

Contractor \_\_\_\_\_

### SECTION PLAT

0			

330 Ft. from N. Line

\_\_\_\_\_ Ft. from S. Line

\_\_\_\_\_ Ft. from E. Line

330 Ft. from W. Line

### FIRST REPORT

Location ✓

Rig up \_\_\_\_\_

Drilling and Remarks:

### RECORD

Cased \_\_\_\_\_ in., \_\_\_\_\_ ft.

Sand \_\_\_\_\_

Gas \_\_\_\_\_

Oil \_\_\_\_\_

Total Depth \_\_\_\_\_

### PRODUCTION

1st 24 hrs. Nat. \_\_\_\_\_

1st 24 hrs. after shot \_\_\_\_\_

Gas \_\_\_\_\_ Cu. Ft.

Dry Hole \_\_\_\_\_

Abandoned \_\_\_\_\_

Date

FEB 10 1937  
19

S. J. LEWIS Scout

Map No. \_\_\_\_\_ Sec. 27 Twp. 11 R. 17W

Well No. 1 Baumse

Deep Rock Company

Contractor

**SECTION PLAT**

0			

330 Ft. from N. Line

\_\_\_\_\_ Ft. from S. Line

\_\_\_\_\_ Ft. from E. Line

330 Ft. from W. Line

**COMPLETED**

Location \_\_\_\_\_

Rig up \_\_\_\_\_

Drilling and Remarks:

*Sil 3443*

*Potential*

*2620*

**RECORD**

Cased \_\_\_\_\_ in., \_\_\_\_\_ ft.

Sand \_\_\_\_\_

Gas \_\_\_\_\_

Oil \_\_\_\_\_

Total Depth 3451

**PRODUCTION**

1st 24 hrs. Nat. \_\_\_\_\_

1st 24 hrs. after shot \_\_\_\_\_

Gas \_\_\_\_\_ Cu. Ft.

Dry Hole \_\_\_\_\_

Abandoned \_\_\_\_\_

Date

APR 14 1937

19

S. J. LEWIS

Scout