

Gove

KANSAS

SECTION 27 TOWNSHIP 11 RANGE 26 W

WELL NO. #1 Neher

COMPANY J-S-I & Durbin Bond

NORTH

							0

9

WEST

EAST

SOUTH

Gove

KANSAS

SEC. 27	TWP. 11	R. 26W
------------	------------	-----------

WELL NO.

#1 Neher

FARM

COMPANY

J-S-F & Durbin Bond

CONTRACTOR

Co. Tools

WILDCAT


_____ Ft. from N. Line

_____ Ft. from S. Line

_____ Ft. from E. Line

_____ Ft. from W. Line

SE NE SE

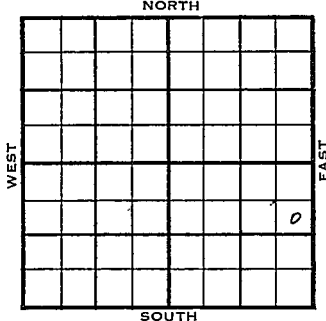

Phillips- DHM

1955	ELEVATION 2632'	REPORT
------	--------------------	--------

12-7 Comm. 12-3-55
8" @ 165/125
Drlg. 1633

12-21 DST 4021-95 op 1 hr. rec. 35' mud,
1100#
DST 4522-37 op 45 min. rec 50' mud,
1000#
D & A
Anh. 2199
H. 3876
L. 3917
BKC 4152
C. 4470
M. 4478
V. 4629
S. 4666
A. 4674
TD 4710'

ABANDONED

County Gove Elev. _____
 Sec. 27 Twp. 11 Rge. 26W
 Company J. S. & Durbin Bond
 Farm Name Neher No. 1

TOPS	DEPTH	LOG	DATUM	Loc. in Sec.																								
Anh.				SE NE SE																								
Tr.																												
H.																												
Dg.																												
Bl.																												
L.				Geol. _____																								
K.C.				Contr. _____																								
B.K.C.				Co. tools _____																								
Ce.				Pool _____																								
C.				Wildcat																								
M.																												
M.				<table border="1"> <tr> <td></td> <td></td> <td></td> </tr> <tr> <td></td> <td></td> <td></td> </tr> <tr> <td></td> <td></td> <td></td> </tr> <tr> <td></td> <td></td> <td></td> </tr> <tr> <td></td> <td></td> <td></td> </tr> <tr> <td></td> <td></td> <td></td> </tr> <tr> <td></td> <td></td> <td></td> </tr> <tr> <td></td> <td></td> <td></td> </tr> </table>																								
K.																												
Mz.																												
Ma.																												
V.																												
S.																												
S.																												
A.																												
R.																												
Pe.																												
G.																												
T.D.																												

Date Comm. 12-3-55 Phillips - DHM
 8" @ 165/125 drlg. 1633

(Large handwritten scribble, possibly "SW")

Co.
Lse.
No.
Sec.
T.
R.

County Gove Elev. 2632
 Sec. 27 Twp. 11 Rgs. 26W
 Company J-S-F & Durbin Bond
 FarmName Neher No. 1

TOPS	DEPTH	LOG	DATUM	Loc. in Sec.																				
Anh. <u>/</u>	<u>2199</u>			<u>SE NE SE</u>																				
Tp.																								
H. <u>/</u>	<u>3876</u>		<u>1238</u>																					
Tr.																								
Dg.																								
BL.																								
L. <u>/</u>	<u>3917</u>		<u>1285</u>	Geol. _____																				
K.C.				Contr. _____																				
B.K.C.	<u>4152</u>		<u>1520</u>	Co. tools _____																				
Ce.				Pool _____																				
C. <u>/</u>	<u>4470</u>		<u>1838</u>	<u>Wildcat</u>																				
M. <u>/</u>	<u>4478</u>		<u>1846</u>																					
M.																								
K.																								
Mz.																								
Me.																								
V. <u>/</u>	<u>4629</u>		<u>1997</u>	<table border="1"> <tr> <td></td> <td></td> <td></td> <td></td> </tr> <tr> <td></td> <td></td> <td></td> <td></td> </tr> <tr> <td></td> <td></td> <td></td> <td></td> </tr> <tr> <td></td> <td></td> <td></td> <td></td> </tr> <tr> <td></td> <td></td> <td></td> <td></td> </tr> </table>																				
S. <u>/</u>	<u>4666</u>		<u>2034</u>																					
S.																								
A. <u>/</u>	<u>4674</u>		<u>2042</u>																					
R.																								
PE.																								
G.																								
T.D.	<u>4710</u>																							

Date Comm. 12-3-55 DEC 21 1955

8" @ 165/125 DST 4021-95 open 1 hr.

rec. 35' mud 1100# DST 4522-37

open 15 min. rec. 50' mud 1000#

D & A