


Section 27 Township 11 Range 26W

Well No. #1 Naher

Company Virginia Drlg.

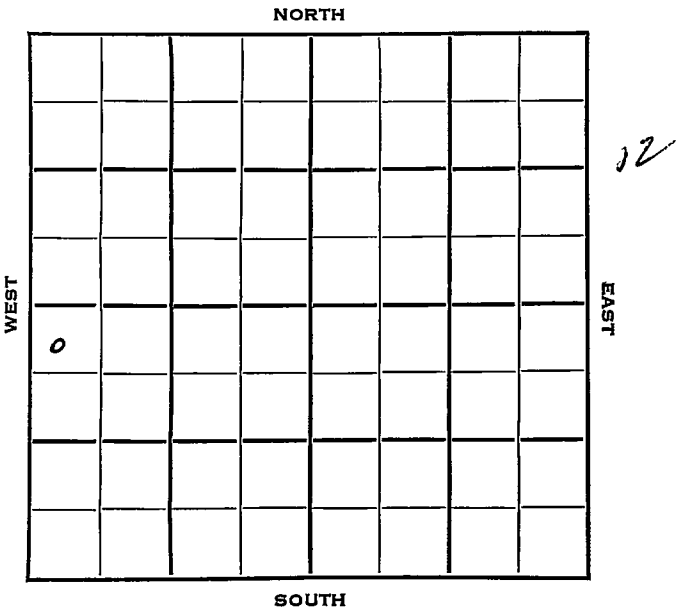

Gove KANSAS


SEC. 27	TWP. 11	R. 26W ✓
------------	------------	-------------

WELL NO. 1 Naher FARM

COMPANY Virginia Drlg.

CONTRACTOR

330 Ft. from N. Line
 _____ Ft. from S. Line
 _____ Ft. from E. Line
 330 Ft. from W. Line

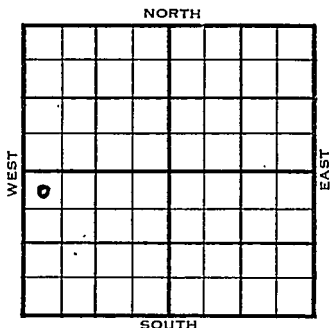

NW NW SW
 Phillips - DHM

	ELEVATION	REPORT
1954	2652'	

3/10 MIR
 3/17 8" @ 235 w/150
 Drlg. 3275
 3/24 Heeb 3891 Tor 3913 Lans 3927
 Miss 4533'
 3/31 Spud 3-10-54
 D &A
 TD 4761'
 8" @ 235'
 Heeb 3891'; Tor 3913'; Lans 3927'
 Miss 4533'; Viola 4657'; Arb 4735'
 TD 4761'
 D &A

ABANDONED

