

Company Shell et al

SOUTH

KANSAS

Ellis



Sec. 28 Twp. 11 R. 18W

Well No. #4 Wasinger Farm

Shell et al

Burnett Pool Company


990' Ft. from N. Line

Ft. from S. Line

979' Ft. from E. Line

Ft. from W. Line

SW NE NE

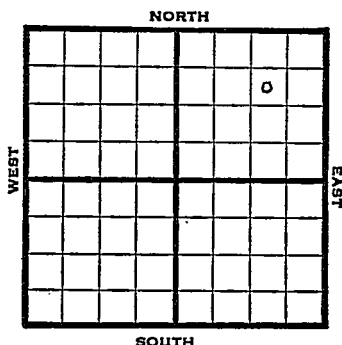

1948 Elev. 2076' REPORT

8/18 8" @ 1355'
WOC
8/25 Drlg 2942'
9/1 Lansing 3282'
Soog 3539'
Drlg. 3595'
9/8 Arb. 3590
TD 3656'
4" @ 3655'
Swb 15 bbls oil PH
9/14 "
9/21 24 shots 3590-94'
500 acid
Swb 116 bbls oil 3 hrs.
9/29 Arbuckle 3590
4" @ 3655'
Echo Pot 3000
Gr. 36°
TD 3656'

COMPLETED

Ellis County Kansas State

Map No. _____ Sec. 28 Twp. 11 R. 18W

Well No. 4 Wasinger

Shell etal. Company

FIRST REPORT Contractor

SW NE NE

SECTION PLAT

990 Ft. from N. Line

_____ Ft. from S. Line

979 Ft. from E. Line

_____ Ft. from W. Line

Burnett Pool

Remarks:

8" @ 1355 WOC

Date
AUG 18 1948

Scout S. J. LEWIS

Map No. 71 Sec. 28 Twp. 11 R. 18WWell No. 4 WasingerShell et al. Company

COMPLETE

Contractor

SW NE NE

E1,2076

SECTION PLAT

990 Ft. from N. Line Ft. from S. Line979 Ft. from E. Line Ft. from W. Line

			6

Ellis CountyLocation Rig up

Drilling and Remarks:

Cr 835904 " @ 3655'Ec 100 ft300036 3/4

RECORD

Cased in., ft.Sand Gas Oil ✓ Total Depth 3656

PRODUCTION

1st 24 hrs. Nat. 1st 24 hrs. after shot Gas Cu. Ft.Dry Hole Abandoned

Date

SEP 29 194819S. I. LEWISScout