


KANSAS Ellis

Section 28 Township 11 Range 18W

Well No. 6 Wasinger

Company Shell et al

Burnett Pool
NORTH

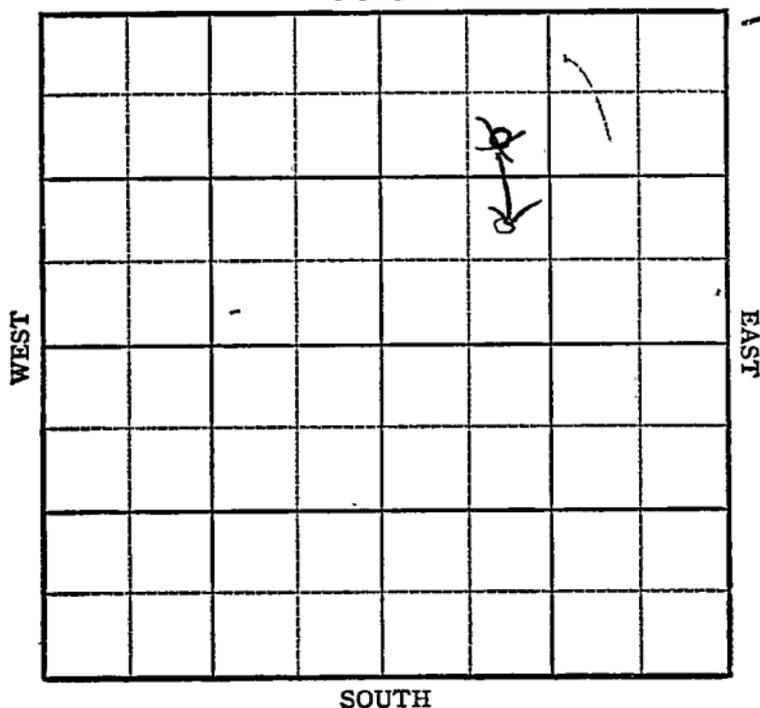

Sec. 28 Twp. 11 R. 18-W ✓

Well No. #6 Wasinger Farm


Shell etal. Company
Burnett Pool

~~990~~ Ft. from N. Line

990 Ft. from S. Line

_____ Ft. from E. Line

990 Ft. from W. Line

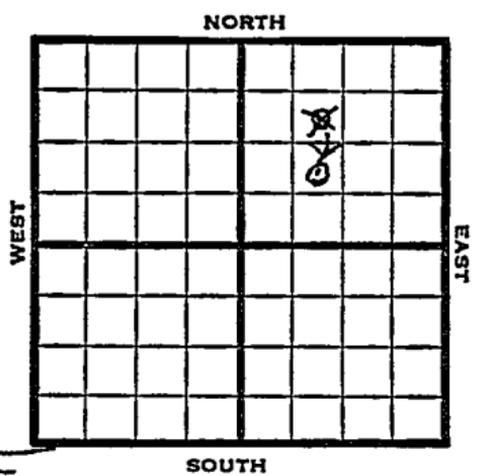

~~SE NW NE~~ NE SW NE

1948 ^{Li} 2082' REPORT

- 11/3 Drlg 465
- 11/10 8" @ 1265'
Drlg. 2596'
- 11/16 Lansing 3282'
Arbuckie 3586'
Drlg. 3649'
- 11/23 Arb. 3586'
TD 3658'
4" @ 3657'
- 11/30 22 shots 3593-3600
1000 acid
Swb 44 bbls oil PH 7 hrs.
- 12/8 " "
- 12/14 TD 3658'
Arb. 3586'
4" @ 3657'
Simp 3575'
Perf Simp 1000 acid
Echo Pot 3000 Oil
36° Gr.
Comp /
COMPLETED

Map No. _____ Sec. 28 Twp. 11 R. 18W

Well No. 6 Wasinger

Shell etal. Company

FIRST REPORT Contractor

SE NW NE

SECTION PLAT

990 Ft. from N. Line

_____ Ft. from S. Line

_____ Ft. from E. Line

990 Ft. from W. Line

		o	

Ellis County

RECORD

Location _____

Cased _____ in., _____ ft.

Rig up _____

Sand _____

Drilling and Remarks:

Gas _____

Oil _____

Total Depth _____

drlg. 465

PRODUCTION

1st 24 hrs. Nat. _____

1st 24 hrs. after shot _____

Gas _____ Cu. Ft.

Dry Hole _____

Abandoned _____

Date

NOV 3 1948 19

S. J. LEWIS

Scout

