

Ellis

## KANSAS


Section 28 Township 11 Range 18WWell No. 1 WasingerCompany Shell & Lario

NORTH

WEST

EAST

SOUTH

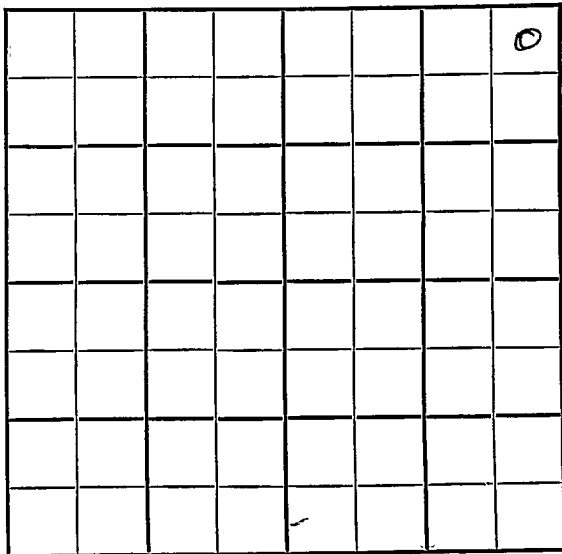

Sec. 28 Twp. 11 R. 18W

Well No. #1 F. Wasinger Farm

Shell & Lario Company  
Burnett


330 Ft. from N. Line

         Ft. from S. Line

330 Ft. from E. Line

         Ft. from W. Line

NE/C

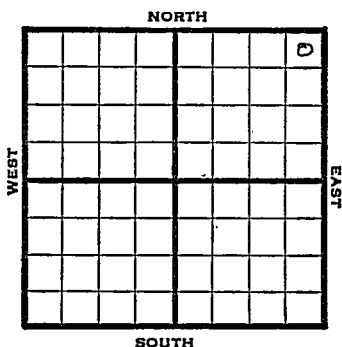

1948

Elev. 1994'

REPORT

4/28

RUR

5/5

8" @ 1278'

Drlg. 2177'

5/12

Topeka 2944'

D<sub>r</sub>lg. 3029'

5/19

Lansing 3207'

Simpson 3495'

Arbuckle 3513'

Drlg. 3528'

5/26

TD 3613'

4 $\frac{1}{2}$ " @ 3612'

RUST

6/1

12 shots 3575-19

24 " 3521-25 swb 331 bbls oil

in 6 hrs.

6/9

"

6/16

TD 3613'

Arb. 3513'

4 $\frac{1}{2}$ " @ 3612'

Perf Echo Pot 3000 Oil

36" Gr.

Comp.

**COMPLETED**


Map No. \_\_\_\_\_ Sec. 28 Twp. 11 R. 18WWell No. 1 F. WasingerShell & Lario Company

## FIRST REPORT

Contractor

NE/C

## SECTION PLAT

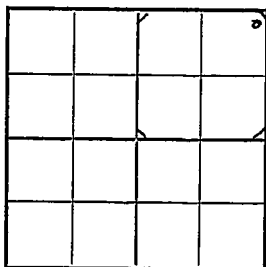330 Ft. from N. Line

\_\_\_\_\_ Ft. from S. Line

330 Ft. from E. Line

\_\_\_\_\_ Ft. from W. Line

Ellis County

Location \_\_\_\_\_

Rig up \_\_\_\_\_

Drilling and Remarks:

R U R

## RECORD

Cased \_\_\_\_\_ in., \_\_\_\_\_ ft.

Sand \_\_\_\_\_

Gas \_\_\_\_\_

Oil \_\_\_\_\_

Total Depth \_\_\_\_\_

## PRODUCTION

1st 24 hrs. Nat. \_\_\_\_\_

1st 24 hrs. after shot \_\_\_\_\_

Gas \_\_\_\_\_ Cu. Ft.

Dry Hole \_\_\_\_\_

Abandoned \_\_\_\_\_

Date

APR 28 194819S. J. LEWISScout


Map No. 71 Sec. 28 Twp. 11 R. 18WWell No. 1 F. WasingerShell & Lario

Company

COMPLETE

Contractor

NE/C

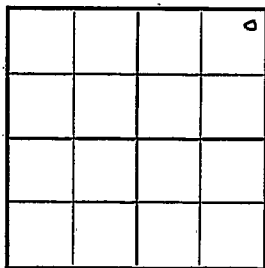E11994  
SECTION PLAT330 Ft. from N. Line       Ft. from S. Line330 Ft. from E. Line       Ft. from W. LineEllis CountyLocation       Rig up       

Drilling and Remarks:

Aug 30/134 1/2" C 36/12Prof.Eclor P 23000oil36 2/3

## RECORD

Cased        in.,        ft.Sand       Gas       Oil ✓Total Depth 3613

## PRODUCTION

1st 24 hrs. Nat.       1st 24 hrs. after shot       Gas        Cu. Ft.Dry Hole       Abandoned       

Date

JUN 16 194819S. J. LEWIS Scout