


Ellis

KANSAS

SECTION 28 TOWNSHIP 11 RANGE 18W

WELL NO. #9 Wasinger

COMPANY Shell Oil

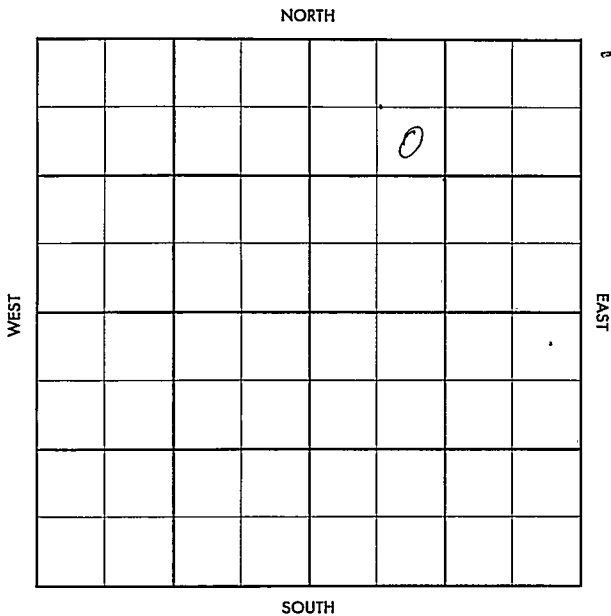

KANSAS

SEC.	TWP.	R.
28	11	18W

WELL NO.

#9 Wasinger

FARM

COMPANY

Shell Oil

CONTRACTOR

Lewis

SW Burnett


Ft. from N. Line

Ft. from S. Line

Ft. from E. Line

Ft. from W. Line

SE NW NE

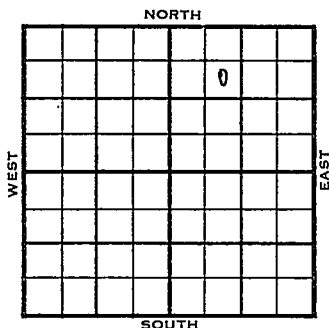

1956
#

ELEVATION

2091

REPORT

3-28

Comm. 3-24-56

Drlg. 300

4-18

8 5/8" @ 1371 w/1000

5 $\frac{1}{2}$ " @ 360L w/200

CO to 3606

B/ 4 go, 32 gwph, 6 hrs., 1000 A

P/ 222 bf 50% wtr., 24 hrs.

Comp. 100 bopd, 100 bw

Anh. 1363

Tr. 3040 3040

L.	3292	3290
----	------	------

C. 3552

S. 3584

A. 3603

TD 3608

COMPLETED

County

~~E113S~~

Elev.

Sec.

28

Twp.

11

Rge.

18W

Company

Shell Oil

FarmName

Wasinger

No.

9

TOPS

DEPTH

LOG

DATUM

Loc. in Sec.

Anh.

Tr.

H.

Tr.

Dg.

Bl.

L.

K.C.

B.K.C.

Ce.

C.

M.

M.

K.

Mz.

Mq.

V.

S.

S.

A.

R.

Pe.

G.

T.D.

SE NW NE

Geol.

Contr.

Lewis

Pool

SW Burnett

FIRST REPORT

MAR 28 '56

Date Comm.

3-24-56

drlg. 300

Co.

Lse.

No.

Sec.

T.

R.

County Ellis Elev. 2091
 Sec. 28 Twp. 11 Rge. 18W
 Company Shell Oil
 Farm Name Wasinger No. 9

TOPS	DEPTH	LOG	DATUM
Anh.	1363		
Top	3040	3040	
H.			
Tr.			
Dg.			
BL.			
L.	3292	3290	1199
K.C.			
B.K.C.			
Ce.			
C.		3552	1468
M.			
M.			
K.			
Mz.			
Mq.			
V.			
S.		3584	1493
S.			
A.		3603	1512
R.			
PE.			
G.			
T.D.	3608		

Loc. in Sec.

SE NW NE

Geol.

Contr.

Lewis

Pool

SM Burnett

COMPLETE

Date Comm. 3-24-56

APR 1 8 1956

8 5/8" @ 1371/1000 5 1/2" @ 3604/200

CO to 3606 B/ 4 go 32 gwph 6 hr.

1000 A P. 222 bf 50% wtr. 24 hr.

Compl 100 bopd 100 bw