

Section 28 Township 11S Range 18W

Well No. 2 Truan

Company Gulf

Burnett

NORTH

			6				

WEST

EAST

SOUTH

6

KANSAS

Ellis

Sec. 28 Twp. 11 R. 18W ✓

Well No. #2 Truan Farm

Gulf

Company

Burnett


_____ Ft. from N. Line

984' Ft. from S. Line

328' Ft. from E. Line

_____ Ft. from W. Line

NE SE NW

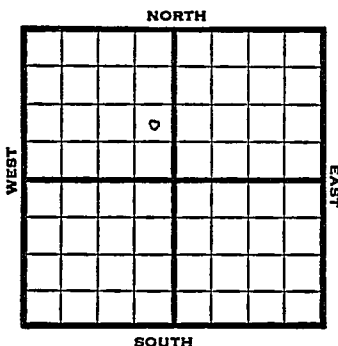

1949

Elev 2031' REPORT

2/9 Location

2/16 "

2/23 8" @ 1413'

3/2 Drlg 2105'

3/8 Lans. 3283'

Arb. 3579' - 85'

TD 3585'

5" @ 3581'

3/16 ↓ gal oil PH

3/23 500 acid bail 19 gals oil & 2 gal W PH

3/30 TD 3597'

PB 3594

1000 acid

Swb 23½ bbls oil / 28 W 22 hrs.

4/6 "

4/12 "

4/20 TD 3597'

Arb. 3579'

5" @ 3581'

1000 acid

Pump 32 Oil / 60 W Pot

36° Gr.

Comp

COMPLETED

KANSAS

Burnett

Map No. _____ Sec. 28 Twp. 11 R. 18 WWell No. 2 TrumanHull Company

FIRST REPORT

Contractor


NESE NW

SECTION PLAT

_____ Ft. from N. Line

984 Ft. from S. Line328 Ft. from E. Line

_____ Ft. from W. Line

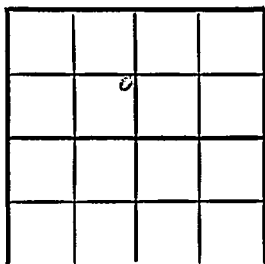EllisLocation

Rig up _____

Drilling and Remarks:

RECORD

Cased _____ in., _____ ft.

Sand _____

Gas _____

Oil _____

Total Depth _____

PRODUCTION

1st 24 hrs. Nat. _____

1st 24 hrs. after shot _____

Gas _____ Cu. Ft.

Dry Hole _____

Abandoned _____

Date

FEB 9 1949 19

S. J. LEWIS Scout

Map No. K71 Sec. 28 Twp. 11 R. 18W

Well No. 2 Truan

Gulf Company

COMPLETE

Contractor

NE SE NW

E12091
SECTION PLAT

	o		

_____ Ft. from N. Line

984 Ft. from S. Line

328 Ft. from E. Line

_____ Ft. from W. Line

Ellis County

Location _____

Rig up _____

Drilling and Remarks:

23579
23581
1000 acid
Run 320lb + 60W
RT
36 lb

RECORD

Cased _____ in., _____ ft.

Sand _____

Gas _____

Oil _____

Total Depth 3057

PRODUCTION

1st 24 hrs. Nat. _____

1st 24 hrs. after shot _____

Gas _____ Cu. Ft.

Dry Hole _____

Abandoned _____

Date

APR 20 1949 19

S. J. LEWIS Scout