


KANSAS Ellis

Section 28 Township 11 Range 18W

Well No. 8 Wasinger

Company Shell & Lario

Burnett Pool
NORTH

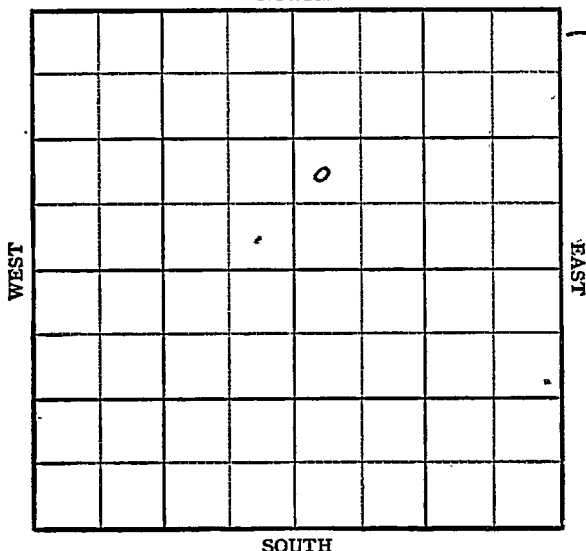

KANSAS

Ellis

Sec. 28 Twp. 11 R. 18W ✓

Well No. #8 Wasinger Farm

Shell & Lario Company
Burnett Pool


_____ Ft. from N. Line

893' _____ Ft. from S. Line

_____ Ft. from E. Line

330' _____ Ft. from W. Line

NW SW NE

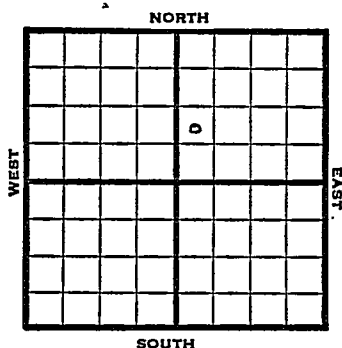

1948	Elev 2068' REPORT
12/15	Location
12/15	"
12/22	RUR
12/29	8" @ 1357
	Drlb 1988
1/ 5	Drlg. 3241'
1/12	Topeka 3027, Lansing 3268
	Simpson 3576, Arbuckle 3592
	TD 3643-4" @ 3642
1/19	30 shots 3588-93 500 acid
	30 shots 3595-3600
	1000 acid
1/26	22 shots 3600-04'
	2000 acid
	Swb 110 bbls oil / 5% W
2/2	"
2/9	22 shots 3600-04'
	2000 acid
	Swb 110 bbls oil / 5% W.
2/16	"
2/23	"
3/2	TD 3643'
	Arb. 3589'
	4" @ 3642'
	Perf Arb 3500 acid
	Bomb Pot 2664 Oil
	36° Gr.
	Comp
	COMPLETED

Map No. _____ Sec. 28 Twp. 11 R. 18W

Well No. 8 Wasinger

Shell & Lario Company

FIRST REPORT

Contractor

NW SW NE

SECTION FLAT

		6	

 Ft. from N. Line

893 Ft. from S. Line

 Ft. from E. Line

330 Ft. from W. Line

Ellis County

Location x

Rig up

Drilling and Remarks:

RECORD

Cased in., ft.

Sand

Gas

Oil

Total Depth

PRODUCTION

1st 24 hrs. Nat.

1st 24 hrs. after shot

Gas Cu. Ft.

Dry Hole

Abandoned

Date

DEC 15 1948

19

S. J. LEWIS

Scout

Map No. K71 Sec. 28 Twp. 11 R. 18WWell No. 8 WasingerShell & Larion

Company

COMPLETE

Contractor

NW SW NE

E13068
SECTION PLAT

Ft. from N. Line

893

Ft. from S. Line

Ft. from E. Line

330

Ft. from W. Line

		a	

Ellis County

Location

Rig up

Drilling and Remarks:

*Art 3588**4 "C3642.**Perf. Art**3500 acid**Born & Art**2664 oil**C3642***RECORD**

Cased _____ in., _____ ft.

Sand _____

Gas _____

Oil _____

Total Depth 3643**PRODUCTION**

1st 24 hrs. Nat. _____

1st 24 hrs. after shot _____

Gas _____ Cu. Ft.

Dry Hole _____

Abandoned _____

Date

MAR 2 1949 19S. J. LEWIS

Scout