


Ellis
KANSASSection 28 Township 11 Range 18WWell No. 1 FisherCompany Sinclair-Prairie

Burnett Pool

NORTH

WEST

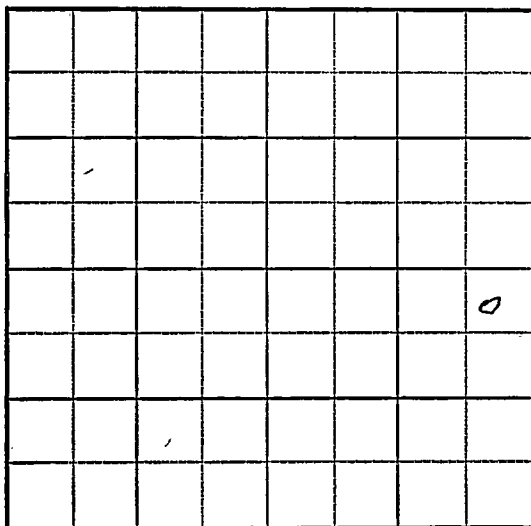

EAST

SOUTH

KANSAS

Ellis

Sec. 28 Twp. 11 R. 18W

Well No. #1 Fisher Farm

Sinclair-Prairie

Company

Burnett Pool


330' Ft. from N. Line

Ft. from S. Line

330' Ft. from E. Line

Ft. from W. Line

NE SE

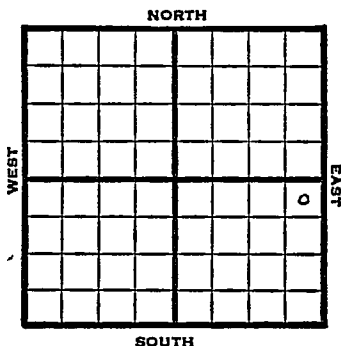

1948	Elev. 2042' REPORT
10/20	Location
10/26	"
11/3	"
11/10	RUR
11/16	8" @ 1307'
	Drlg. 1620'
11/23	Drlg 2765'
11/30	Lansing 3280'
	Simpson 3543'
	Arbuckle 3563'
	TD 3623'
12/8	5" @ 3622'
12/15	"
	52 shot s 3562-71
	3000 acid
	Swb 60 bbls oil PH
12/22	Arb 3563'
	5" @ 3633'
	Perf.
	3000 acid
	Depth Pot. 1858 oil & 28 W Pot.
	Gr. 38°
	TD 3623'
	COMPLETED

Map No. _____ Sec. 28 Twp. 11 R. 18W

Well No. 1 Fisher

Sinclair-Prairie Company

FIRST REPORT Contractor

NE SE

SECTION PLAT

330 Ft. from N. Line

_____ Ft. from S. Line

330 Ft. from E. Line

_____ Ft. from W. Line

			4
			6

Ellis County

Location X

Rig up _____

Drilling and Remarks:

RECORD

Cased _____ in., _____ ft.

Sand _____

Gas _____

Oil _____

Total Depth _____

PRODUCTION

1st 24 hrs. Nat. _____

1st 24 hrs. after shot _____

Gas _____ Cu. Ft.

Dry Hole _____

Abandoned _____

Date

OCT 20 1948 19

S. J. LEWIS Scout

Kansas

Burnett Pool

Map No. 71 Sec. 28 Twp. 11 R. 18WWell No. 1 Fisher


Sinclair-Prairie

Company

COMPLETE

Contractor

NE SE

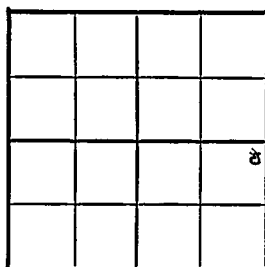E. 2042
SECTION PLAT330 Ft. from N. Line Ft. from S. Line330 Ft. from E. Line Ft. from W. Line

Ellis County

Location Rig up

Drilling and Remarks:

CE 435635" C 3523Perf.3000 acDepth 195 ft128 W 242524

RECORD

Cased in., ft.Sand Gas Oil Total Depth 3623

PRODUCTION

1st 24 hrs. Nat. 1st 24 hrs. after shot Gas Cu. Ft.Dry Hole Abandoned

Date

DEC 22 1948 19S. I. LEWIS

Scout