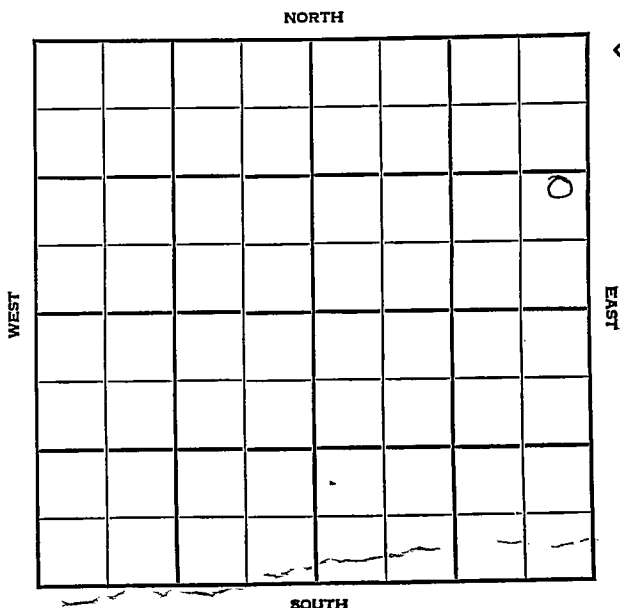


Section 28 Township 11 Range 18 ~~W~~Well No. #2 WasingerCompany Shell etal

KANSAS

Ellis

Sec. 28 Twp. 11 R. 18W

Well No. #2 Wasinger Farm

Shell et al Company

Burnett Pool


1695' Ft. from N. Line

Ft. from S. Line

330' Ft. from E. Line

Ft. from W. Line

NE SE NE

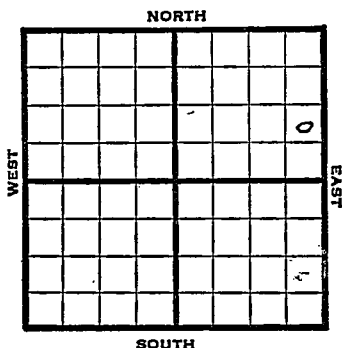

1948

Elev. 2059' REPORT

6/30 Location

7/8 8" @ 1345'

Drlg 1350'

7/14 Drlg 3034'

7/21 Topeka 3001'

Lansing 3265'

Arbuckle 3574'

TD 3630'

Rum csg.

7/28 4" @ 3628'

29 shots 3573-83'

Swb 120 bbls oil 3 hrs.

8/4 "

8/11 Arbuckle 3574'

4" @ 3628'

TD 3630'

29 shots 3573-83

Echo Pot. 3000 oil Pot.

Gr. 36.6°

COMPLETED

Map No. _____ Sec. 28 Twp. 11 R. 18W

Well No. 2 Wasinger

Shell et al. _____ Company

FIRST REPORT _____ Contractor

NE SE NE

SECTION PLAT

1695 Ft. from N. Line

_____ Ft. from S. Line

330 Ft. from E. Line

_____ Ft. from W. Line

			o

Ellis County

Location X

Rig up

Drilling and Remarks:

RECORD

Cased _____ in., _____ ft.

Sand _____

Gas _____

Oil _____

Total Depth _____

PRODUCTION

1st 24 hrs. Nat. _____

1st 24 hrs. after shot _____

Gas _____ Cu. Ft.

Dry Hole _____

Abandoned _____

Date

JUN 30 1948 19 S. J. LEWIS Scout

Ellis County Kansas State

Map No. 71 Sec. 28 Twp. 11 R. 18W

Well No. 2 Wasinger

Shell et al. Company

COMPLETE

Contractor

NE SE NE


E. 2059
SECTION PLAT

1695 Ft. from N. Line

 Ft. from S. Line

330 Ft. from E. Line

 Ft. from W. Line

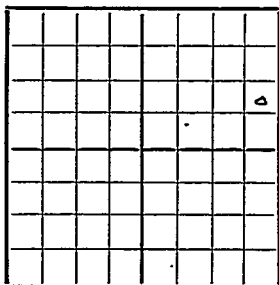

Burnett Pool

Remarks:

Cor 3574

4 " @ 3628

7173630

2944 to 3573 - 93

Ech 1500 oil 120

36 5/8

Date
AUG 11 1948

Scout
S. J. LEWIS