


Section 28 Township 11 Range 19-W

Well No. #2 Solomon

Company Glen Nye

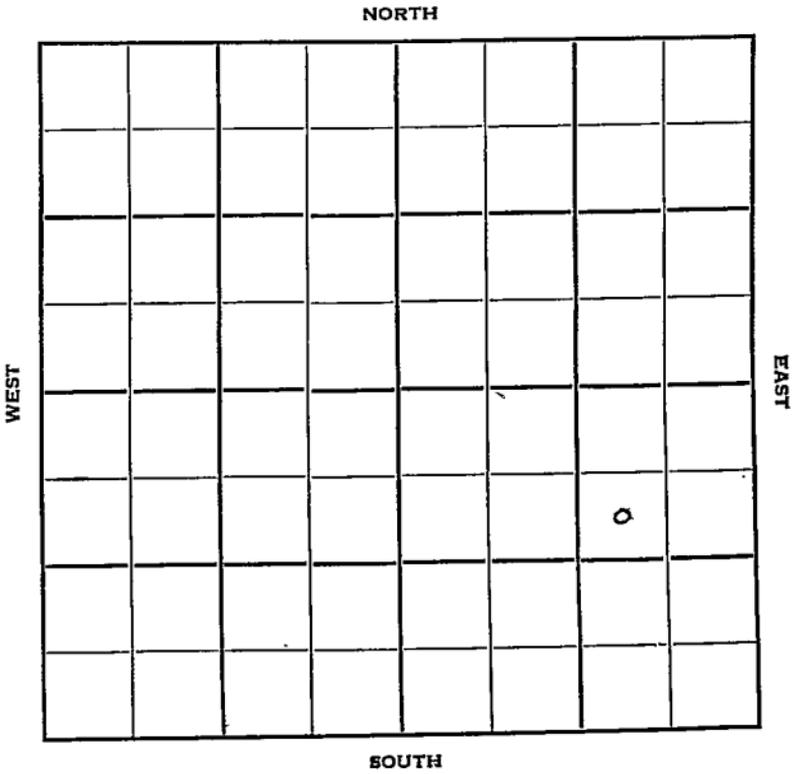

Sec. 28 Twp. 11 R. 19W

Well No. #2 Solomon Farm

Glen Nye Company

Contractor


990' Ft. from N. Line

Ft. from S. Line

990' Ft. from E. Line

Ft. from W. Line

SW NE SE

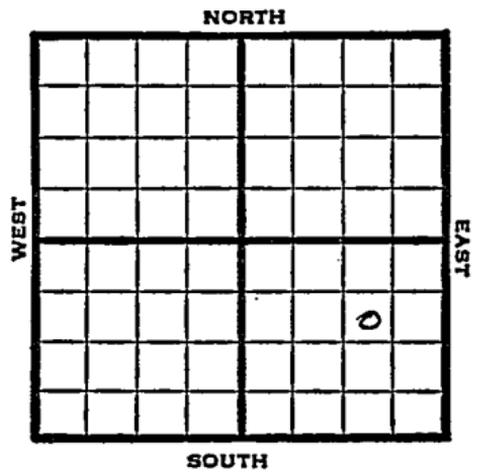

1950

Elev 2116

REPORT

6/28 Spud 6-23-50  
 8-5/8" @ 147'  
 Anhy 1415'  
 Drlg. 1460'

7/19 8 5/8" @ 147

Anhy 1415

Lans 3344

Simp 3608

5" @ 3631

S/6 1/2 boph

1000 acid

Comp Depthograph Pot. 1020 bopd

Completed

Heeb 3300  
 Cong 3598  
 Arb 3630-32

**COMPLETED**

Kansas

Map No. \_\_\_\_\_ Sec. 28 Twp. 11 R. 19W

Well No. 2 Solomon

Glen Nye

Company

Contractor

SW NE SE

990 Ft. from N. Line

\_\_\_\_\_ Ft. from S. Line

990 Ft. from E. Line

\_\_\_\_\_ Ft. from W. Line

## SECTION PLAT

FIRST REPORT			
			o

Ellis County

Location \_\_\_\_\_

Rig up \_\_\_\_\_

Drilling and Remarks:

Spud 6-23-50

8 5/8" @ 147

Anhy 1415

drlg. 1460

## RECORD

Cased \_\_\_\_\_ in., \_\_\_\_\_ ft.

Sand \_\_\_\_\_

Gas \_\_\_\_\_

Oil \_\_\_\_\_

Total Depth \_\_\_\_\_

## PRODUCTION

1st 24 hrs. Nat. \_\_\_\_\_

1st 24 hrs. after shot \_\_\_\_\_

Gas \_\_\_\_\_ Cu. Ft.

Dry Hole \_\_\_\_\_

Abandoned \_\_\_\_\_

Date

JUN 28 1950 19

J. E. TYRA Scout

Kansas

Map No. \_\_\_\_\_ Sec. 28 Twp. 11 R. 19WWell No. 2 SolomonGlen Nye

Company

Contractor


SW NE SE

E1. 2116  
SECTION PLAT990 Ft. from N. Line

\_\_\_\_\_ Ft. from S. Line

990 Ft. from E. Line

\_\_\_\_\_ Ft. from W. Line

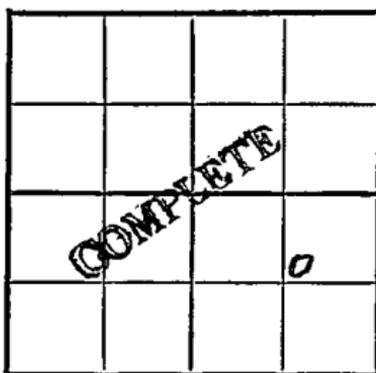

Ellis County

Location \_\_\_\_\_

Rig up \_\_\_\_\_

Drilling and Remarks:

8 5/8" @ 147

Anny 1415

Heeb. 3300

Lans. 3344

Cong. 3598

Simp. 3608

Arb. 3630-32

5" @ 3631

## RECORD

Cased \_\_\_\_\_ in., \_\_\_\_\_ ft.

Sand \_\_\_\_\_

Gas \_\_\_\_\_

Oil \_\_\_\_\_

Total Depth 3632

## PRODUCTION

1st 24 hrs. Nat. \_\_\_\_\_

1st 24 hrs. after shot \_\_\_\_\_

Gas \_\_\_\_\_ Cu. Ft.

Dry Hole \_\_\_\_\_

Abandoned \_\_\_\_\_

Date

JUL 10 1950

19

J. E. TYRA

Scout

S/ 6 1/2 boph

1000 acid

Comp. Depthograph Pot. 1020

Misc.
Pierce Map
France Map
Tracings
Land Walk Map
Land Small Map
Scout Cards

AUG 1 1951

DEPT. OF THE ARMY  
WASHINGTON, D. C.

RECEIVED  
MAY 1951

RECEIVED  
MAY 1951


SECTION 517

RECEIVED  
MAY 1951