


Ellis

Section 28 Township 11 Range 19-W

Well No. 1 - Solomon (Solomon)

Company Sunray Oil

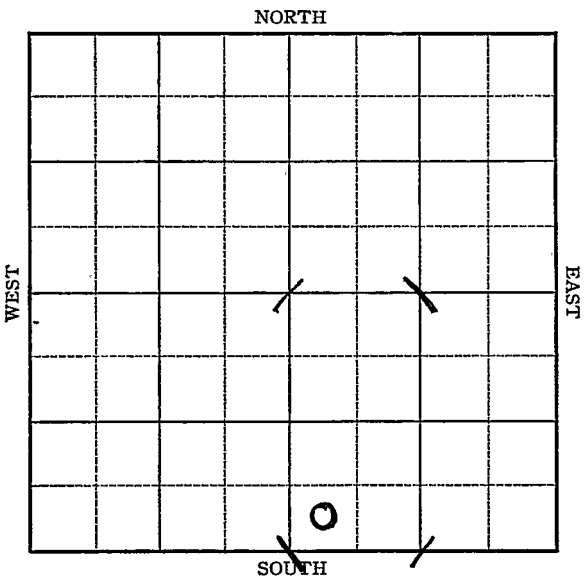

Sec. 28 Twp. 11 R. 19-W

Well No. #1 Solomon Farm

Sunray Oil Company


_____ Ft. from N. Line

330 Ft. from S. Line

_____ Ft. from E. Line

330 Ft. from W. Line

Elev. 2100

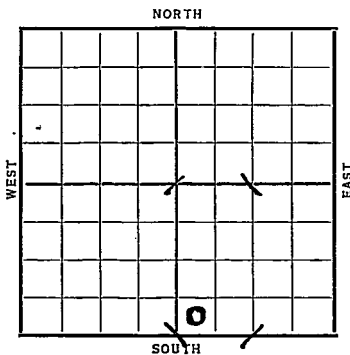

Date	REPORT
1937	
6/9	15" @ 110'.
	Anhy 1410'.
	Drlg. 1740'.
6/19	Drlg. 3082'.
6/25	Sil. 3631'? SDO
7/2	T.D. 3641' small S.O.
7/9	" " " "
7/16	7" @ 3624'. T.D. 3648'.
	900' water & S.O.
7/23	" " "
7/30	" " "
8/4	7" @ 3634'
	Sil 3632'
	TD 3648' (S.W.)
	BB 3624'
	18 shots 3495-3515'
	No shows
	D&A
	ABANDONED

Ellis KANSAS

Map No. 70 Sec. 28 Twp. 11 R. 19^w

Well No. 1 - Solomon

Sunray Oil Company
Contractor

FIRST REPORT

SECTION PLAT

_____ Ft. from N. Line

330 Ft. from S. Line

1 Ft. from E. Line

330 Ft. from W. Line

Location _____

Rig up _____

Drilling and Remarks:

15" 110
Anty-1410
Dlg -1740

RECORD

Cased _____ in., _____ ft.

Sand _____

Gas _____

Oil _____

Total Depth _____

PRODUCTION

1st 24 hrs. Nat. _____

1st 24 hrs. after shot _____

Gas _____ Cu. Ft.

Dry Hole _____

Abandoned _____

Date

JUN 9 1937 19

H. D. Hatfield Scout

Ellis KANSASMap No. 70 Sec. 28 Twp. 11 R. 19 WWell No. 1 - SolomonSunray Company
Contractor

SECTION PLAT

ABANDONED

_____ Ft. from N. Line

330 Ft. from S. Line

_____ Ft. from E. Line

330 Ft. from W. Line

		0	

Location _____

Rig up _____

Drilling and Remarks:

P.B. 362418 shots 3495-3515No ShowsDVA

RECORD

Cased 7 in., 3634 ft.Sand 511 3632

Gas _____

Oil _____

Total Depth 3648 (sw)

PRODUCTION

1st 24 hrs. Nat. _____

1st 24 hrs. after shot _____

Gas _____ Cu. Ft.

Dry Hole _____

Abandoned _____

Date

AUG 4 - 1937H. D. Hatfield Scout