


Section 28 Township 11 Range 19W

Well No. #6 Solomon (A)

Company Don Pratt

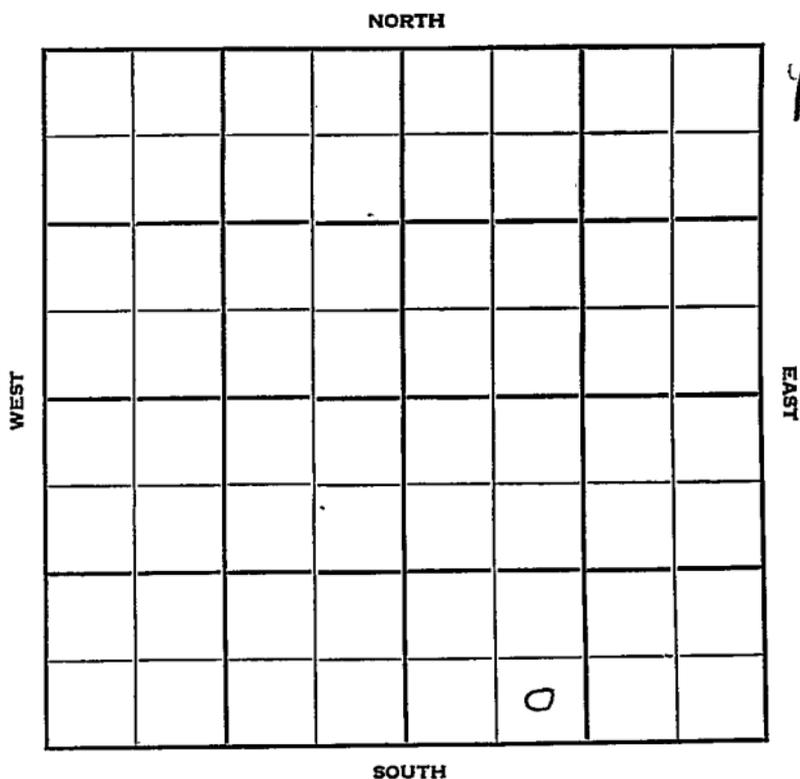

Ellis

Sec. 28 Twp. 11 R. 19W

Well No. #6 Solomon (A) Farm

Don Pratt Company

Savage & Dunn Contractor  
Solomon


..... Ft. from N. Line

330' Ft. from S. Line

..... Ft. from E. Line

990' Ft. from W. Line

SE SW SE

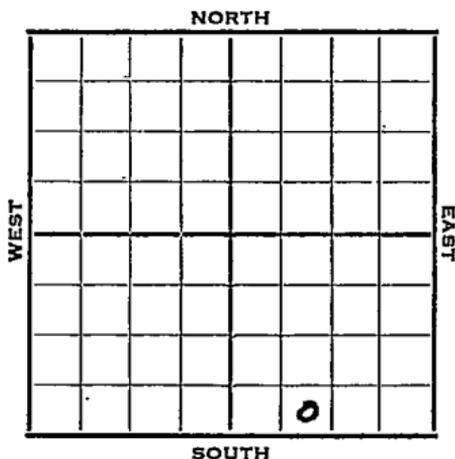

1952

Elev. 2134' REPORT

8/27

Spud 8-25-52  
8" @ 160

9/3

Anhy 1435' Heeb. 3339  
Lans. 3380  
Drlg. 3604'

9/10

D & A - Hold

9/17

Spud 8-25-52  
D&A TD 3716' 8" @ 160'  
Anhy 1435' Heeb. 3339  
Lans. 3380  
DST 3650-70 open 1 hr. rec. 5' mud  
O# Simp. 3665 Arb. 3701'  
TD 3716' D&A

**ABANDONED**



