

Section 28 Township 11 Range 19 W


Well No. #7 Soloman (A) (Solomon "A")

Company Don Pratt

NORTH

WEST

EAST

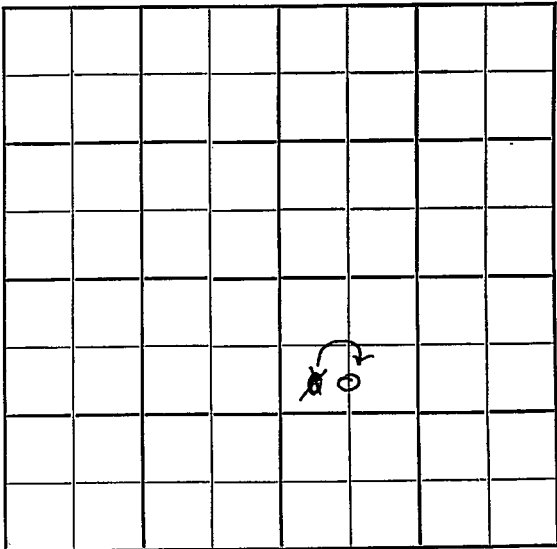

SOUTH



Sec. 28 Twp. 11 R. 19 W

Well No. # 7 Solomon (A) Farm

Don Pratt Company

Contractor

990 Ft. from N. Line

Ft. from S. Line


Ft. from E. Line

660

330 Ft. from W. Line

C-S L NW SE

SW NW SE

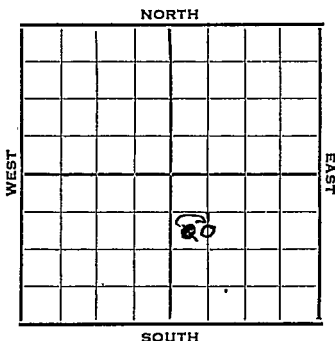

1952 Elev. 2103' REPORT

9/10 Spud 9-5-52

8" @ 160

Anhy 1400'

Drlg. 1950'

9/17 Heeb 3294' Lans. 3337'

Drlg. 3597'

9/24 Arb. 3629' TD 3664' 5" @ 3664

10/1 (Cor 5" @ 3659, RTD 3660, Arb 3625)
CO 3651 gamma-ray 18/3624-26 fill up
1200' oil 1st hr., S/20 BOPH for
3 hrs.,
POP

10/8 "

10/15 "

10/22 Spud 9-5-52

Oil Well

TD 3660'

8" @ 160'

Anhy 1400', Heeb. 3294', Lans. 3337',

Arb. 3625'

TD 3660'

5" @ 3659'

CO to 3651'

18/3624-26 FU 1200' oil

S/20 boph 3 hr.

Comp. 209 bopd

COMPLETED

County Ellis State Kansas

Sec. 28 (Blk. Twp.) 11 (Sur. Rge.) 19W Map No.

Operator Don Pratt

Well No. 7 Farm Solomon (A)

Elev. _____ Location SW NW SE

990 Ft. From N Line SE

330 Ft. From W Line Quarter

1st. Report SEP 10 1952

Completion _____

Remarks _____

Spudding Date 9-5-52

Drlg. Data _____

8" @ 160 Anhy 1400 Drlg. 1950

J. G. McGEHEE

Kansas

Map No. _____ Sec. 28 Twp. 11 R. 19W

Well No. 7 Solomon "A"

Don Pratt _____ Company

CORRECTION _____ Contractor

C S L NW SE

SECTION PLAT

990 Ft. from N. Line

_____ Ft. from S. Line

_____ Ft. from E. Line

660 Ft. from W. Line

		o	

Ellis County

Location _____

Rig up _____

Drilling and Remarks:

Reported

SW NW SE

RECORD

Cased _____ in., _____ ft.

Sand _____

Gas _____

Oil _____

Total Depth _____

PRODUCTION

1st 24 hrs. Nat. _____

1st 24 hrs. after shot _____

Gas _____ Cu. Ft.

Dry Hole _____

Abandoned _____

Date

SEP 17 1952 19

J. G. McGEHEE

Scout

