


Section 28 Township 11 Range 19-W

Well No. #1 Solomon "B"

Company Don Pratt

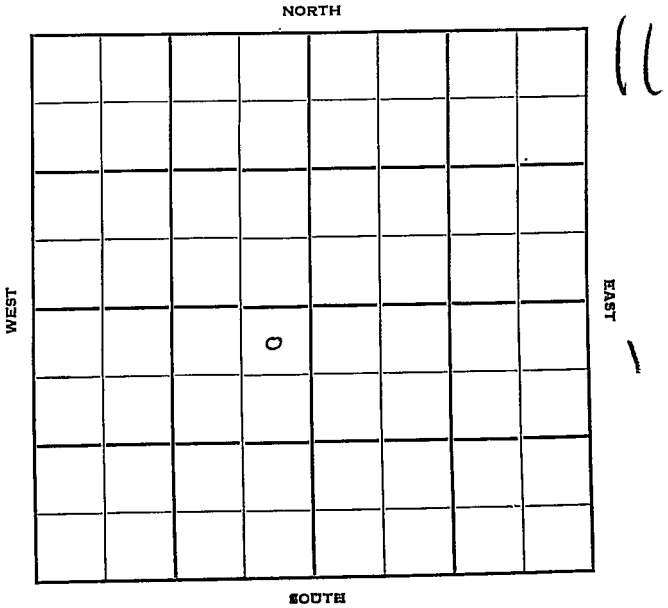

Sec. 28 Twp. 11 R. 19W

Well No. #1 Solomon "B" Farm

Don Pratt Company

Overland Drlg. Contr. Contractor


Riverview Pool

330' Ft. from N. Line

_____ Ft. from S. Line

330' Ft. from E. Line

_____ Ft. from W. Line

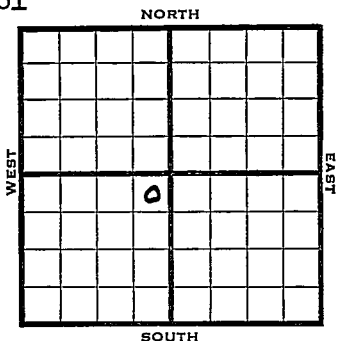

NE NE SW

1950 Elev. 1994' REPORT

8/23 MIM
 9/27 Spud. 8-23-50
 Oil Well TD 3529'
 8" @ 166' Anhy 1305'
 Lans. 3240' Cong. 3490'
 Simp. 3511' Arb. 3525'
 DST 3526-29 opn 30 min. Rec. 150'
 fluid 120' was oil 30' OGM
 5" @ 3526'
 TD 3529 FU 1500' oil 2 hr.
 P/5 BOPH Comp. 38 BOPD

COMPLETED

