

Sec. 28 Twp. 11 R. 19W

Well No. #2 Solomon "B" Farm

Don E. Pratt Company

Overland Contractor

_____ Ft. from N. Line


330' Ft. from S. Line

330' Ft. from E. Line

_____ Ft. from W. Line

SE SE SW

(180' NW of dry hole)

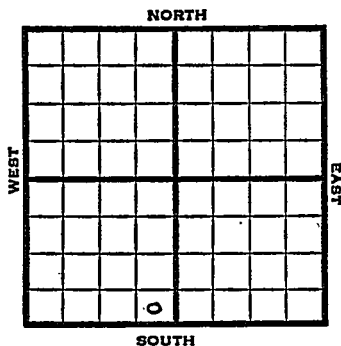

1951

Elev. 2115'

REPORT

4/18

Spud 4-13-51
8" @ 162'
Anhy 1335'
Drlg. 1985'

5/9

Spud 4-13-51
D & A TD 3644'
8" @ 162 Anhy 1335', Heeb 3309',
Lans. 3352'
DST 3516-26 open 45 min. rec 90' SO &
GGSW
Cong. 3607', Simp. 3625', Arb. 3641',
5" @ 3642' TD 3644' 500 A
S/6 BOPH B/3 BFPH 1500 A
water SSO D & A

ABANDONED

