KANSAS


FORM 51 5M 2-38 TPCO.

Ellis

Section 28 Township 11 Range 17-W

Well No. 3 Bemis "E"

Company Margay

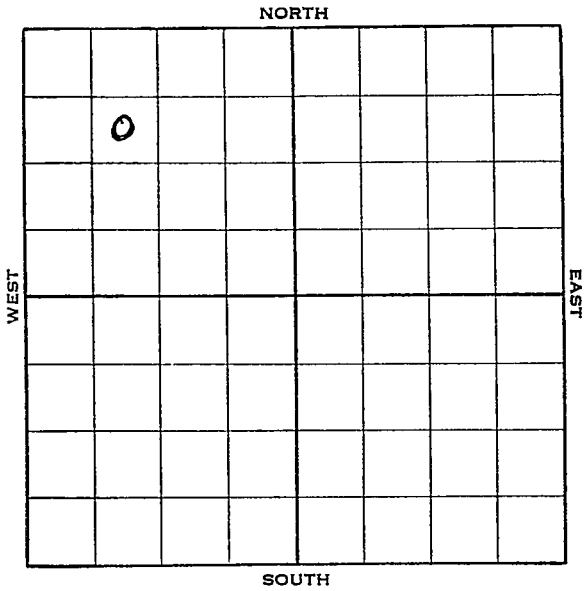

4

FORM 252-A 5M 1-38 KANSAS - Ellis

Sec. 28 Twp. 11 R. 17-W

Well No. #3 Bemis "E" Farm


Margay Company

990 Ft. from N. Line

Ft. from S. Line

Ft. from E. Line

990 Ft. from W. Line

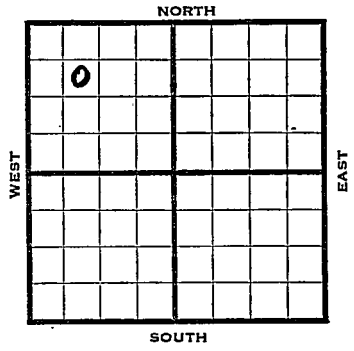

Elev. 1960

1938	REPORT
3/30	R. R.
4/8	15" @ 28'. WOC.
4/15	Anhy 1192'. 10" @ 1195'.
	Drlg. 2160'.
4/22	Drlg. 2932'.
4/29	Arb. & 7" @ 3458'. T.D. 3459'.
	RUST.
5/6	T.D. 3466' H.F.O.
5/10	7" @ 3458'.
	Arb. 3458'.
	T.D. 3466'.
	Potential 1915 bbls., Nat'l.
	COMPLETED

Form 26—1M Bks.—2-29 Ellis KANSAS

Map No. 71 Sec. 28 Twp. 11 R. 17W

Well No. 3 Bemis "E"

Margay Company

Contractor

FIRST REPORT

SE NW NW


990 Ft. from N. Line

Ft. from S. Line

Ft. from E. Line

990 Ft. from W. Line

SECTION PLAT

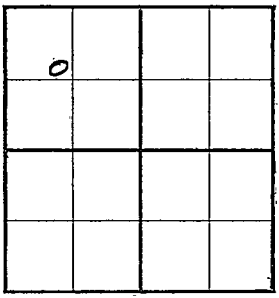

Location

Rig up

Drilling and Remarks:

R.R1

RECORD

Cased in., ft.

Sand

Gas

Oil

Total Depth

PRODUCTION

1st 24 hrs. Nat.

1st 24 hrs. after shot

Gas Cu. Ft.

Dry Hole

Abandoned

Date

MAR 30 1938 19 H. D. Hatfield Scout

Form 26—1M Bks.—2-29

Ellis KANSAS

Map No. 71 Sec. 28 Twp. 11 R. 17W

Well No. 3 Bemis "E"

Margay Company

Contractor

COMPLETED

SE NW NW


990 Ft. from N. Line

Ft. from S. Line

Ft. from E. Line

990 Ft. from W. Line

SECTION PLAT

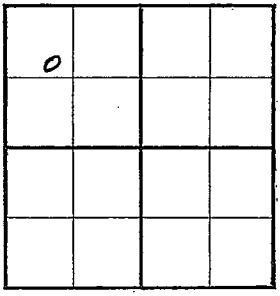

Location

Rig up

Drilling and Remarks:

POT 1915

NOT

RECORD

Cased 7 in., 3458 ft.

Sand ARB 3458

Gas

Oil

Total Depth 3466

PRODUCTION

1st 24 hrs. Nat.

1st 24 hrs. after shot

Gas Cu. Ft.

Dry Hole

Abandoned

Date

MAY 10 1938 19

H. D. Hatfield Scout